

**WPX Energy Rocky Mountain LLC**

**AP 521-20-695**


**PARACHUTE Field**

**SHL: 81' FNL 2509' FWL (NE/4 NW/4) Section 20 T6S R95W 6th PM**

**BHL: 1049' FNL 1250' FWL (NE/4 NW/4) Section 20 T6S R95W 6th PM**

**Garfield County Colorado**

**Formation Tops**  
(Measured Depths)

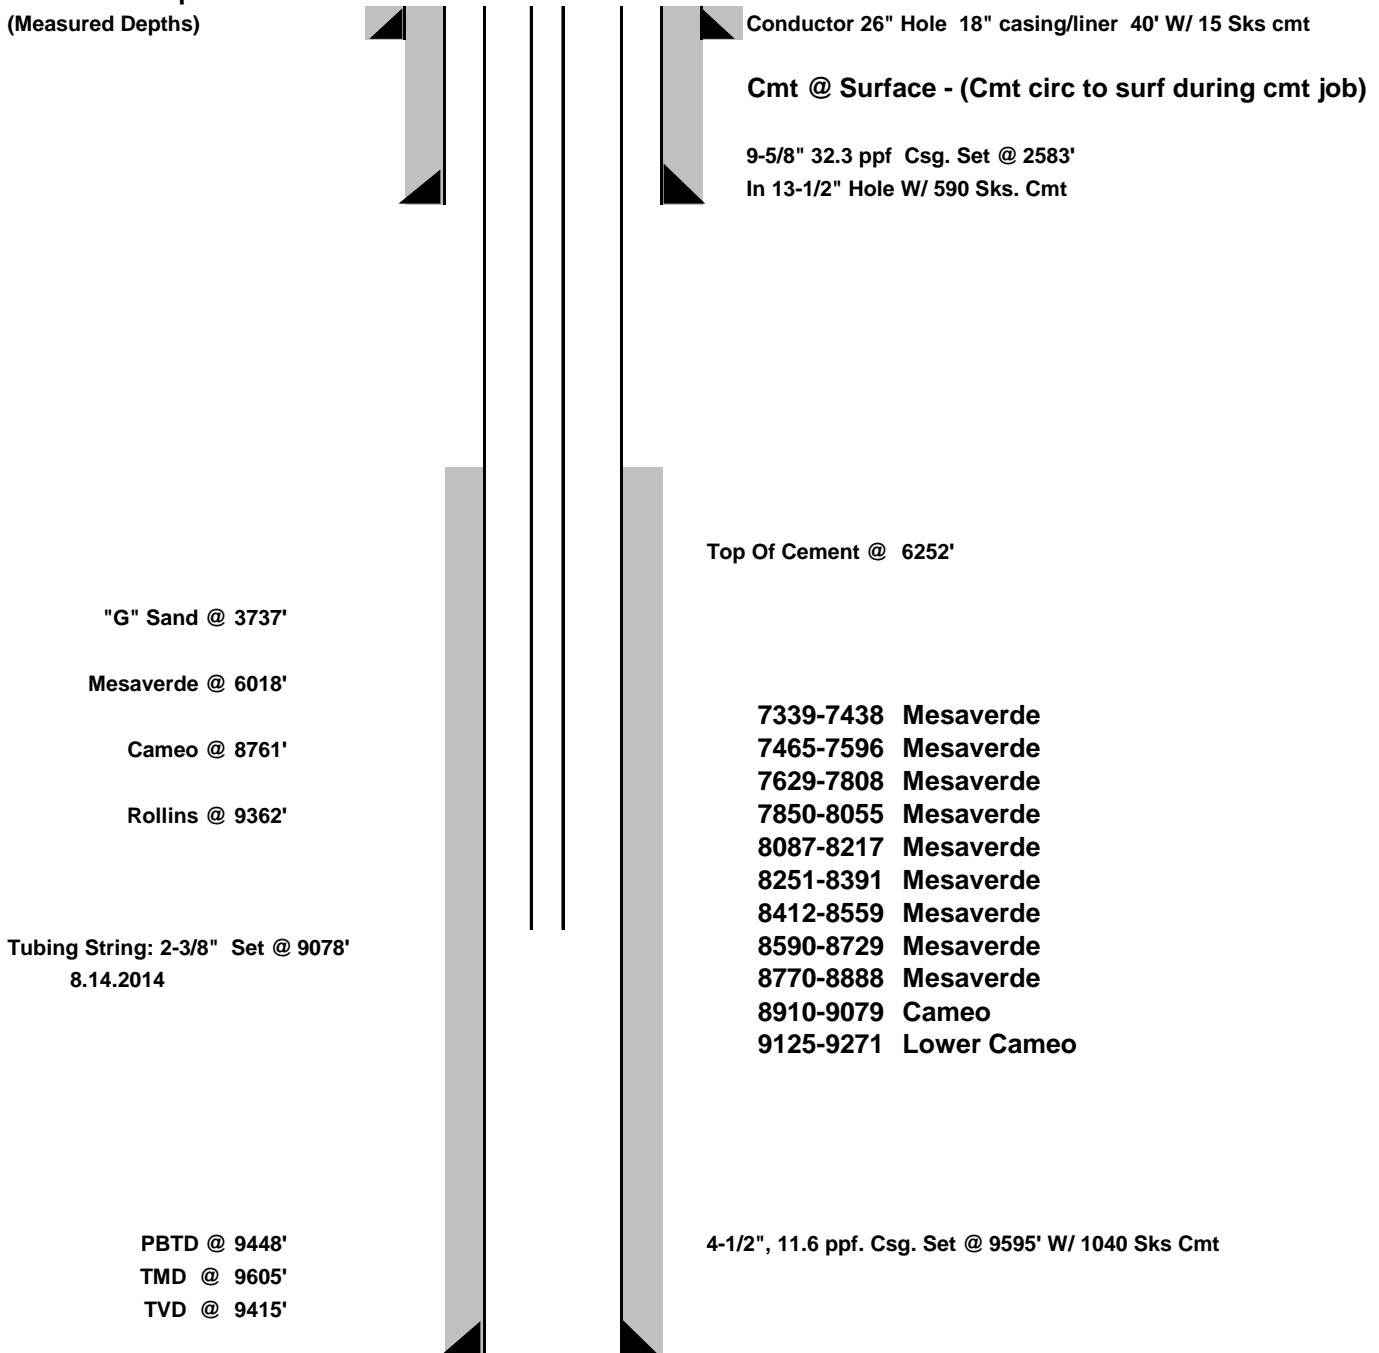

**DATE CREATED: 12.31.2014**

**NOTE: THIS IS NOT TO SCALE.**  
**\*\*FINAL\*\***