

12/19/14


LOWEN 20-32

TANK BATTERY

N

EXCAV
AREA

Scale 1:1

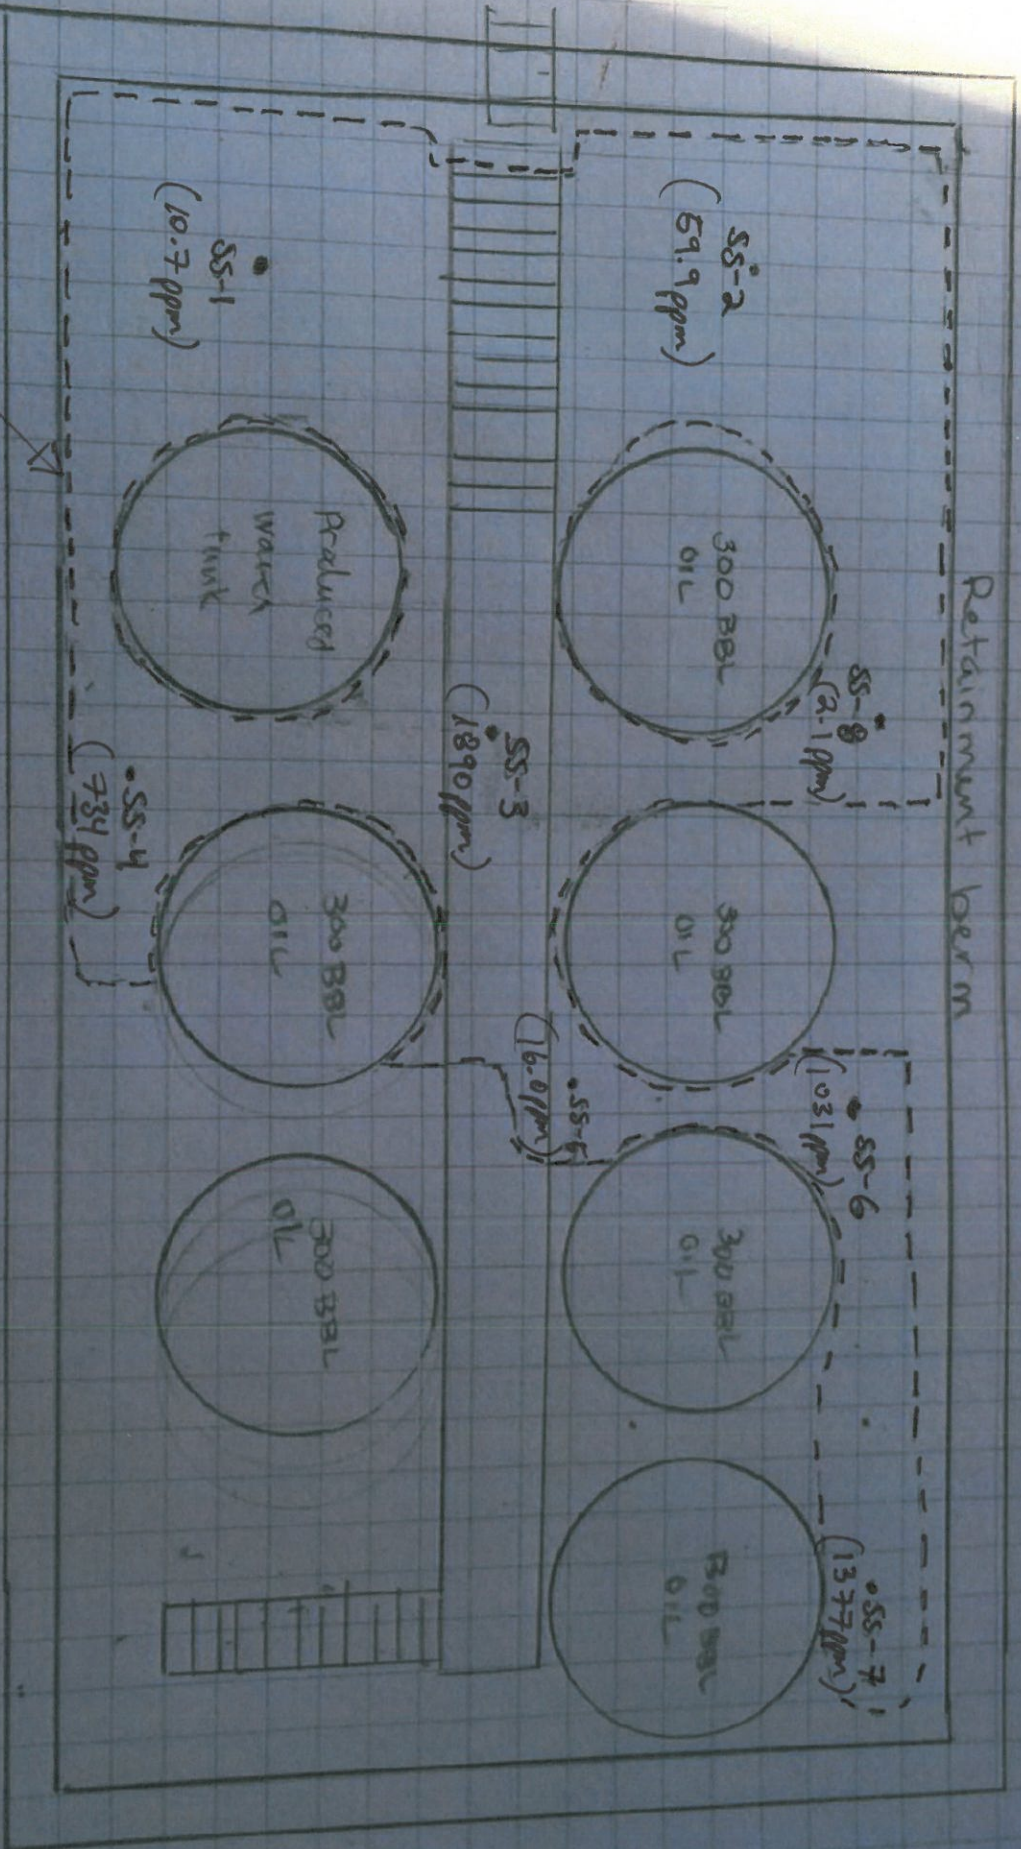

EXCAVATION AREA / SPILL AREA