



ENVIRONMENTAL  
CONSTRUCTION  
COMPLIANCE

Project # 1-10488-1434 Date 12/9/14  
Site Laewen  
Project Excavation By KM

← N  
Scale 1:10


--- excavation area

Excavation area 35' x 61' x 10"

Soil Sample depth 310

1	1'	10.7 ppm
2	1'	59.9 ppm
3	1'	1840 ppm
4	1'	734.9
5	1'	16.2 ppm
6	1'	1031 ppm
7	1'	1377 ppm
8	1'	2.1 ppm

12/28		
3	2'	1065
4	2'	317.6
6	2'	7.8
7	2'	38.2

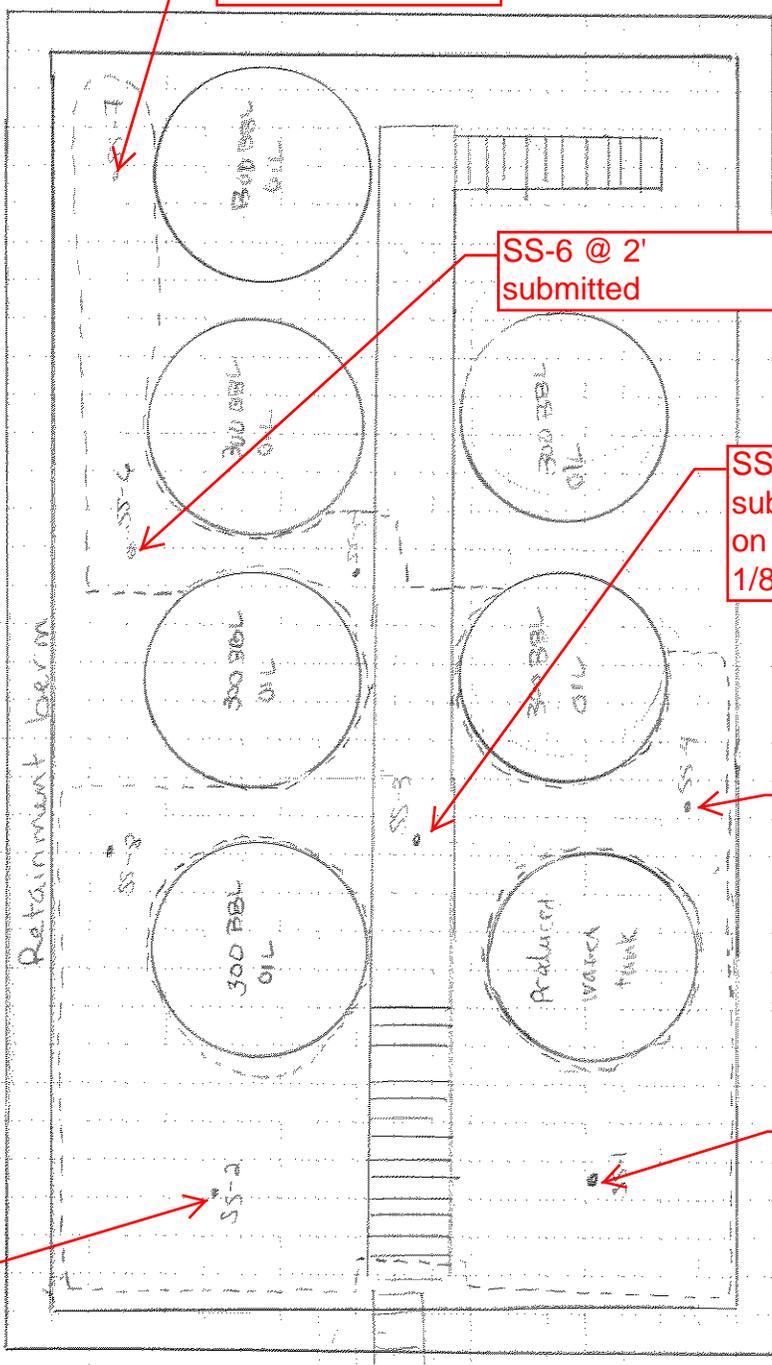

SS-7 @ 2'  
submitted

SS-6 @ 2'  
submitted

SS-3 @ 3.5'  
submitted; waiting  
on results as of  
1/8/15

SS-4 @ 3.5'  
submitted; waiting  
on results as of  
1/8/15

SS-1 @ 1'  
submitted

SS-2 @ 1'  
submitted

All samples consisted of: SANDY CLAY: med brown, med plastic, moist