


KERR-MCGEE OIL AND GAS ONSHORE LP
ST. ACACIUS 29-35
SW NW 35 3N 68W 1,437' FNL 1,101' FWL
WELD,COLORADO
01/19/2015

AREA: W2 **ROUTE: W22** **Spud: 08/02/2007** **WINS No.: 93295** **AFE/WO#: 88653577** **API#: 0512325139**

GL: 4920 **KB: 4932** **MTD: 7650** **TVD: 7411** **LOG MD: 7657** **PBMD: 7625** **PBTVD: 7386**

Directions: **CR 9 & 28, E 1/2, S 1/2, W INTO**

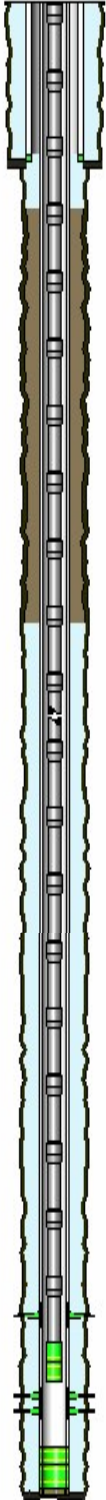

<u>HOLE SECTIONS</u>		<u>Size</u>	<u>Top</u>	<u>Btm</u>	<u>TD Date</u>			
DRILL SURFACE HOLE		12.25	12	905	08/03/2007			
DRILL TO PRODUCTION		7.88	905	7650	08/08/2007			
<u>TUBULARS</u>		<u>Tool Type</u>	<u>Joints</u>	<u>Size</u>	<u>Weight</u>	<u>Grade</u>	<u>Thread</u>	<u>Top D</u> <u>Bottom D</u>
SURFACE CASING		Casing	20	8.63	24.00	J-55	STC	12 894
			1	8.63	24.00	ST-95	STC	894 895
PRODUCTION CASING		Casing	182	4.50	11.60	I-80	LT&C	12 7625
		Baffle	1	4.50		I-80		7625 7625
		Shoe Joint	1	4.50	11.60	I-80	LT&C	7625 7639
		Casing Float Shoe	1	4.50		I-80		7639 7641
PRODUCTION TUBING		Tubing	237	2.38	4.70	J-55	External-Ups	12 7449
		XN Profile Nipple	1	2.38				7449 7450
		Notched Collar	1	2.38				7450 7451
<u>CEMENT JOBS</u>		<u>Stage</u>	<u>Sacks</u>	<u>Cement Jobs</u>		<u>Top D</u>	<u>Btm D</u>	<u>cbf</u>
SURFACE CASING		PRIM CMT 1ST STAGE	310	LEAD	LITE	12	600	No
		PRIM CMT 1ST STAGE	100	TAIL	TYPE 2	600	895	No
PRODUCTION CASING		PRIM CMT 1ST STAGE	195	LEAD	LITE	3482	4711	Yes
		PRIM CMT 1ST STAGE	130	MIDDLE	LITE	4711	6824	Yes
		PRIM CMT 1ST STAGE	170	TAIL	50/50 POZ-MIX	6824	7650	Yes
PRODUCTION CASING		ONE INCH JOB	155	LEAD	CEMENT	795	1625	Yes
<u>PERFORATIONS</u>		<u>Formation</u>	<u>Zone</u>	<u>Top</u>	<u>Btm</u>	<u>Date</u>	<u>Reason</u>	<u>Comments</u>
		NIOBRARA	A	7232	7238	04/14/2010	PRODUCTION	
		NIOBRARA	B	7282	7292	04/14/2010	PRODUCTION	
		NIOBRARA	C	7356	7364	04/14/2010	PRODUCTION	
		CODELL		7485	7505	11/02/2007	PRODUCTION	

Comments: