

**KERR-MCGEE OIL AND GAS ONSHORE LP**

**UPRC 19-16J**

**SE SE 19 3N 65W 621' FSL 474' FEL**

**WELD,COLORADO**

**12/28/2014**

**AREA: E1**

**ROUTE: E13**

**Spud: 05/06/1992**

**WINS No.: 21355**

**AFE/WO#: 88611218**

**API#: 0512315734**

**GL: 4922**

**KB: 4934**

**MTD: 7435**


**TVD: 7435**

**LOG MD:**

**PBMD: 7372**

**PBTVD:**

**Directions: CR 32 & CR 39, S 8/10, W 1/10, N INTO.**

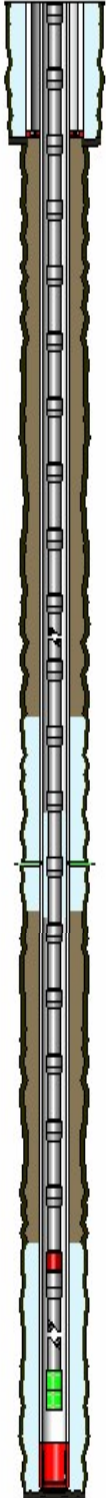

<u>HOLE SECTIONS</u>	<u>Size</u>	<u>Top</u>	<u>Btm</u>	<u>TD Date</u>
SURFACE	12.25	12	750	05/07/1992
PRODUCTION	7.88	750	7435	05/11/1992

<u>TUBULARS</u>	<u>Tool Type</u>	<u>Joints</u>	<u>Size</u>	<u>Weight</u>	<u>Grade</u>	<u>Thread</u>	<u>Top D</u>	<u>Bottom D</u>
SURFACE CASING	Casing	17	8.62	23.00	WC-50		12	730
	Casing Float Shoe	1	8.62				730	732
PRODUCTION CASING	Casing	174	4.50	11.60	M-75		12	7413
	Casing Float Shoe	1	4.50				7413	7415
PRODUCTION TUBING	Tubing	209	2.38	4.70	J-55	8RD EUE	12	6683
	Wellbore Equipment	1					6683	6690
	Tubing	18	2.38	4.70	J-55	8RD EUE	6690	7258
	XN Profile Nipple	1					7258	7259
	Notched Collar	1			J-55		7259	7259

<u>CEMENT JOBS</u>	<u>Stage</u>	<u>Sacks</u>	<u>Cement Jobs</u>		<u>Top D</u>	<u>Btm D</u>	<u>cbl</u>
SURFACE CASING	PRIM CMT 1ST STAGE	360	LEAD	FRESH WATER	12	732	No
PRODUCTION CASING	PRIM CMT 1ST STAGE	150	LEAD	FRESH WATER	3850	4343	Yes
	PRIM CMT 2ND STAGE	200	TAIL	FRESH WATER	6635	7415	Yes
PRODUCTION CASING	SQUEEZE JOB	50	LEAD	FRESH WATER	4440	4870	Yes
	SQUEEZE JOB	50	TAIL	FRESH WATER	4343	4440	Yes
PRODUCTION CASING	SQUEEZE JOB	75	LEAD	FRESH WATER	4608	4613	No
PRODUCTION CASING	ABANDONMENT PLUC	40	LEAD	FRESH WATER	4371	4900	No

<u>PERFORATIONS</u>							
<u>Formation</u>	<u>Zone</u>	<u>Top</u>	<u>Btm</u>	<u>Date</u>	<u>Reason</u>	<u>Comments</u>	
		4428	4428	08/08/1994	CEMENT SQUEEZE	SQZ HOLES 2 HOLES TOTAL	
SUSSEX		4608	4613	08/10/1994	PRODUCTION		
		4800	4800	08/08/1994	CEMENT SQUEEZE	SQZ HOLES 2 HOLES TOTAL	
NIOBRARA		7110	7128	07/11/2005	PRODUCTION		
NIOBRARA		7140	7158	07/11/2005	PRODUCTION		
CODELL		7284	7300	05/14/1992	PRODUCTION		
CODELL		7284	7300	04/23/2002	PRODUCTION		

**Comments:**