


4-4-I well

BOTTOM HOLE LOCATION MAP

SMU 6-4-I PAD

Free Mineral Lease

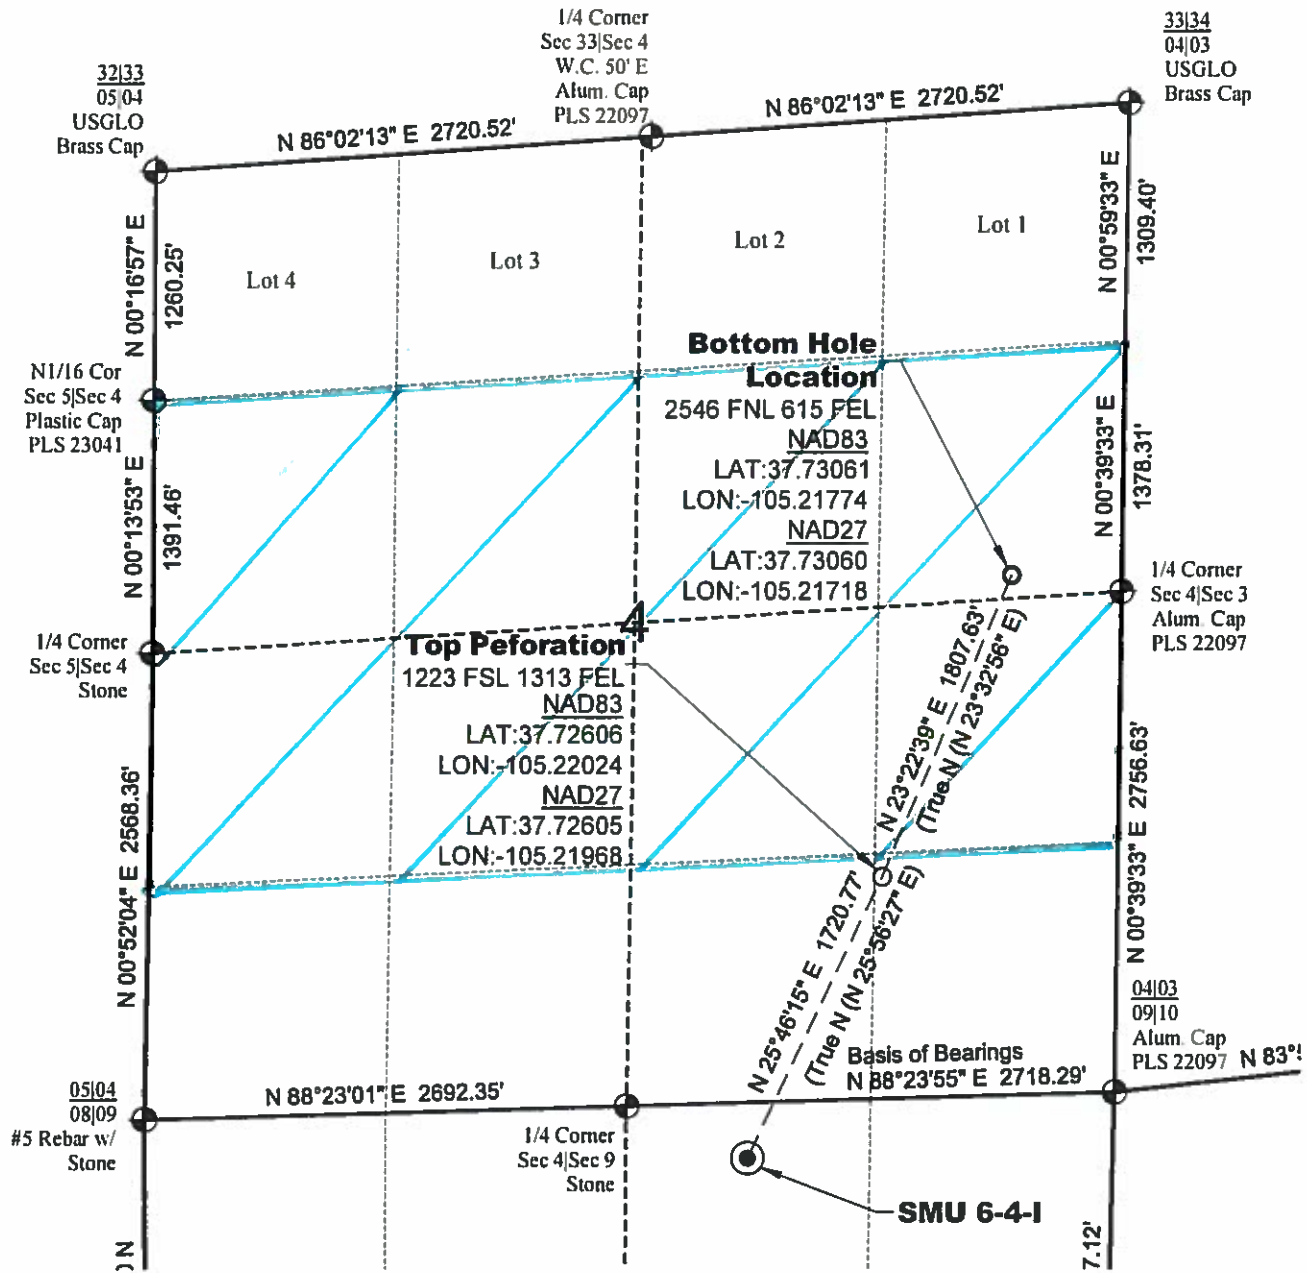

North

0 1000 2000

Graphic Scale in Feet
1" = 1000'



LAND SURVEYING AND MAPPING
LAFAYETTE - WINTER PARK
Ph 303 666 0379 Fx 303 665 6320

OXY PERMIAN
SMU 6-4-I

SL NW1/4 NE1/4 SEC.9 T27S R70W
TD NE1/4 SE1/4 SEC.4 T27S R70W
6th PM HUERFANO COUNTY COLORADO

SMU 6-4-J Pad Federal Minerals

