

LEGEND

- ◆ ~ FOUND ORIGINAL STONE
- ⊕ ~ FOUND GLO BRASS CAP ON STEEL POST
- ⊗ ~ FOUND MONUMENT SET BY OTHERS AS NOTED
- ~ SET MONUMENT AS NOTED
- ~ WELL HEAD
- (M) ~ MEASURED IN FIELD
- L ~ 90° SYMBOL
- WC ~ WITNESS CORNER


BASIS OF BEARING:

THE LINE FROM THE N 1/4 CORNER TO THE NE CORNER OF SECTION 19, TOWNSHIP 11 SOUTH, RANGE 89 WEST, 6TH P.M., WAS ASSUMED TO BEAR N. 89°05'46" E. AS MONUMENTED AND SHOWN HEREON.

CERTIFICATE OF SURVEY:

I, David G. Nicewicz, a Registered Land Surveyor in the State of Colorado, do hereby certify that the survey represented by this plat was made under my direction and supervision, and that this plat accurately represents this survey.

David G. Nicewicz P.L.S. No. 24963
(for and on behalf of URS Corporation)

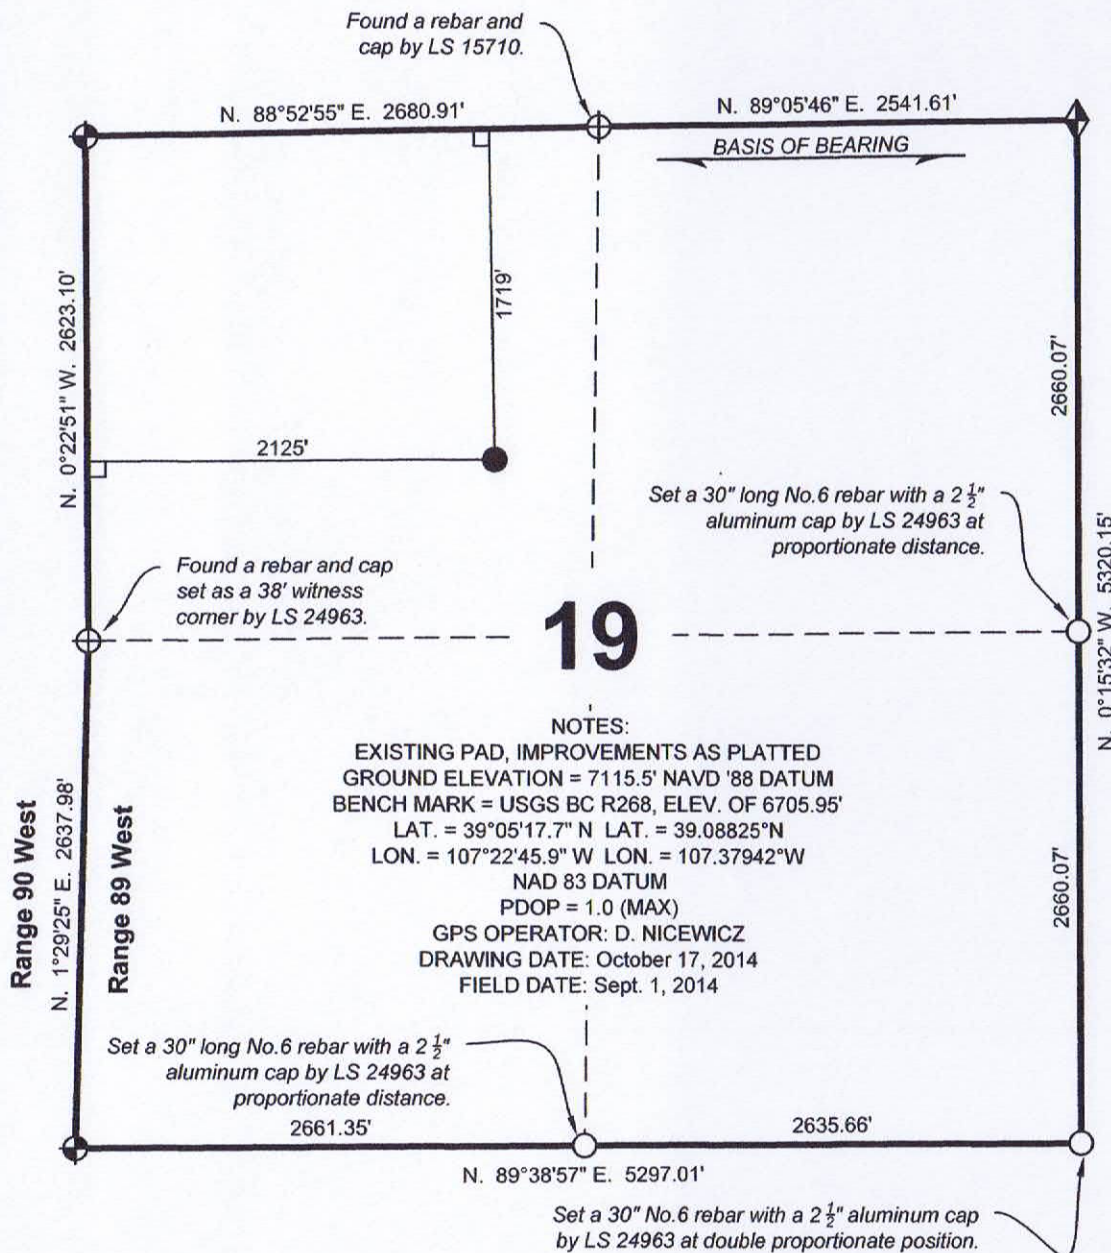

URS CORP. OF GLENWOOD SPRINGS COLORADO, has in accordance with a request from ERIC SANFORD, for SG INTERESTS I, LTD, determined the location of HL 11-89-19 #2 to be 1719 FNL & 2125 FWL Section 19, Township 11 South, Range 89 West, of the Sixth Principal Meridian, Gunnison County, Colorado.

GAS WELL LOCATION PLAT

SG INTERESTS I, LTD.

HL 11-89-19 #2

NW 1/4 Section 11, T. 11 S., R. 89 W., 6th P.M.,
Gunnison County, Colorado

SURVEYED BY:
DGN

DWG DATE:
10/17/14

David G. Nicewicz, PLS

DRAFTED BY:
MLD

SCALE:
1" = 1000'

cell: (720) 456-1104
david.nicewicz@urs.com

URS Corp.
804 Colorado Ave, Suite 201
Glenwood Springs Co 81610

JOB NO.: 22243490.12000

SHEET NO. 1 of 1