


Well Name: Anschutz Equus Farms 4-62-15-
0659CH2

Before P & A

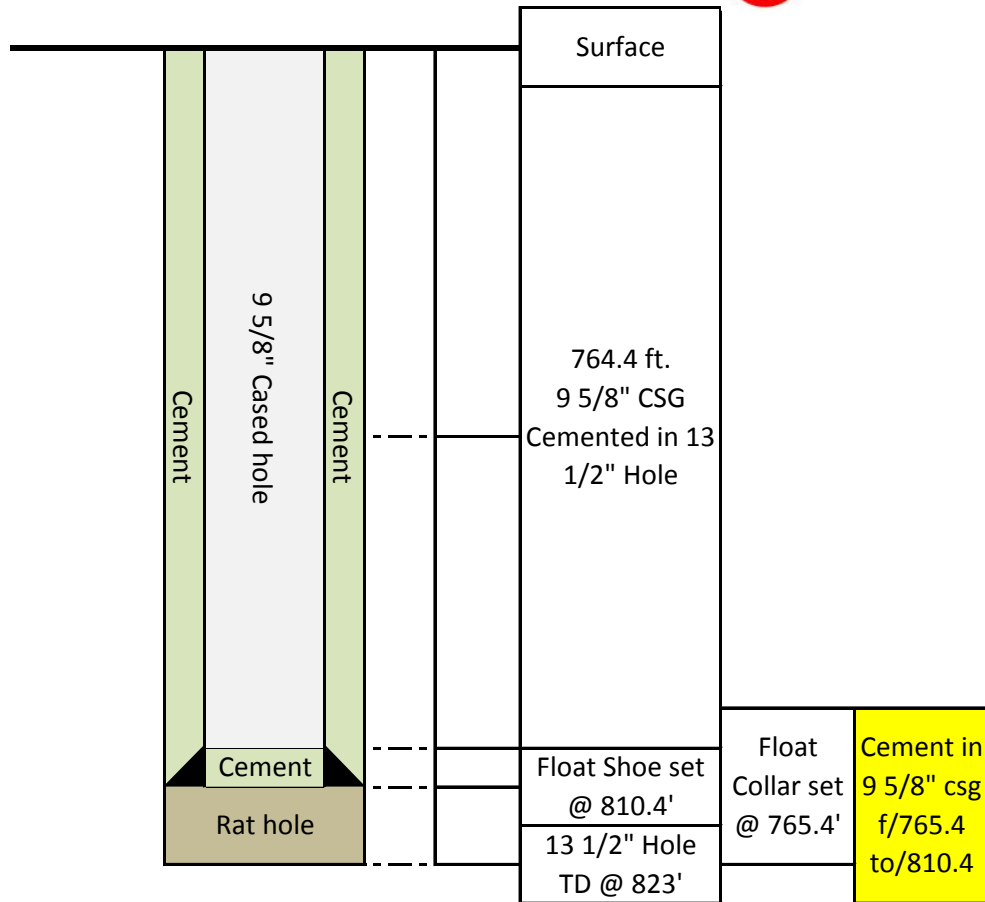

Well Name: Anschutz Equus Farms 4-62-15-
0659CH2

After P & A

