

Owner: Magpie Operating Inc	Well Name: Ihnen # 2
County: Larimer	Pool: —
Field: Loveland	Sec: 31 Twp: 5N Rng: 68W
Coordinates: SWNE	


Wellbore diagram

Current

1/12/15

Bore Diameters (in.)

12 1/4
7 7/8

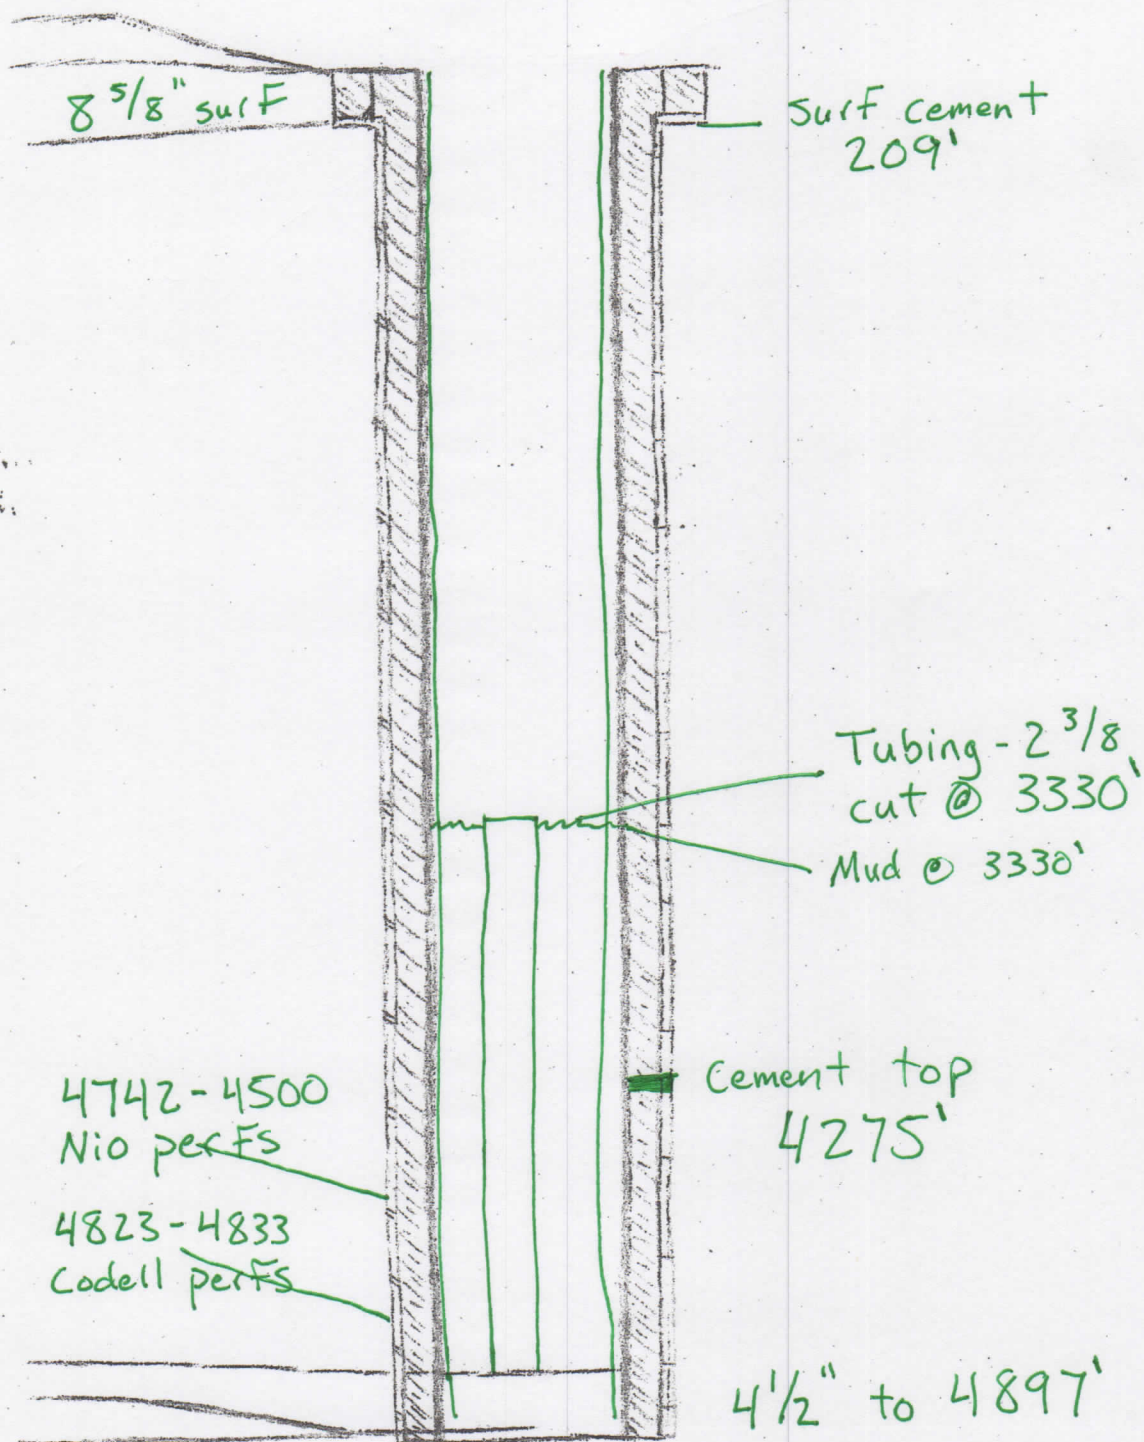

Owner: Magpie Operating, Inc. Well Name: Ihnon # 2
 County: Larimer Field: Loveland Pool: —
 Coordinates: SW NE Sec: 31 Twp: 5N Rng: 68E

Well bore diagram

