




Exploration and Production

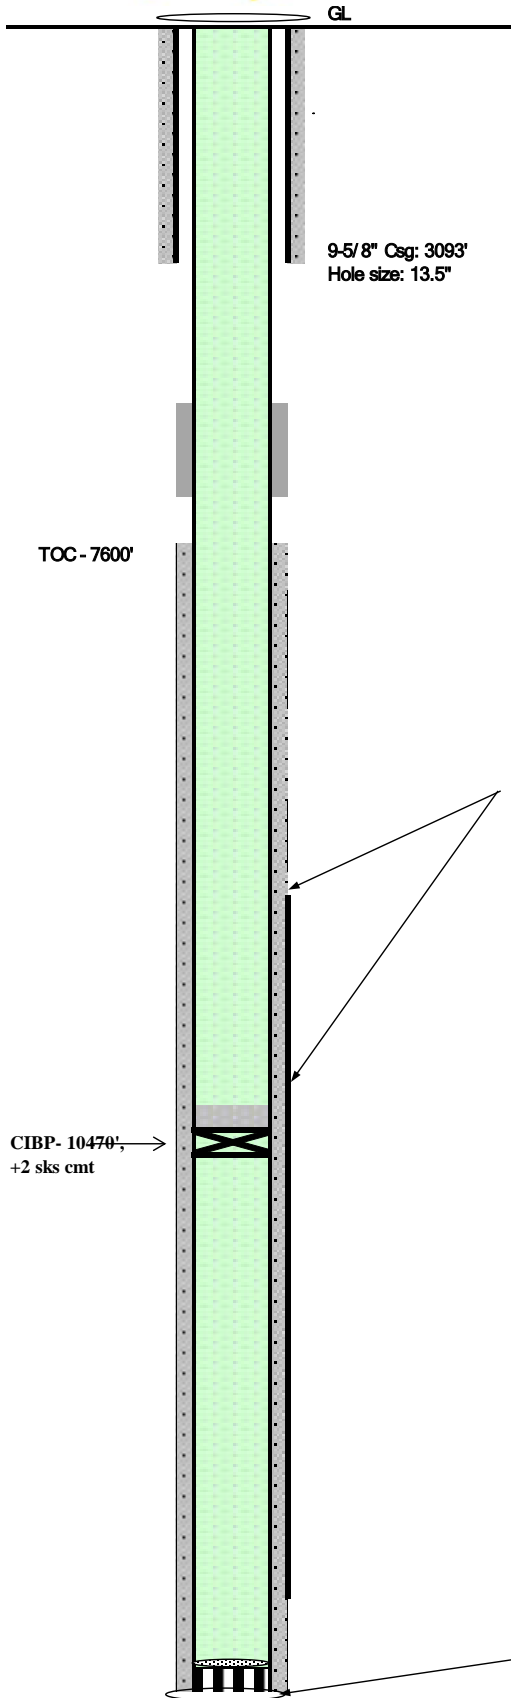

Well Name **AP 522-9-695**
 Location **NWSE 9 6S 95W**
 Field **ALLEN POINT**
 County **Garfield, CO**
 API **05-045-14039**

Spud 07/03/2007

Casing	3093'	9-5/8" 32.3# H-40
Cement	880 sx	
Casing	11856'	4-1/2" 11.6# I-110
Cement	844 sx	

Tubing 10229'

Formation Tops

Mesaverde 9276'

TOC - Bond Log 7600'

Completed Intervals

	<u>Depth</u>	<u># Holes</u>
<u>MV</u>	9276' - 10439'	94