


Williams Et Al 24-1

1980 FSL720 FWL NWSW 24 5N 61W 6th PM
Lat 40.38493 Long -104.16353 (from footages)
Weld County, Colorado
API #05-123-09642

Spud date 12/23/1978

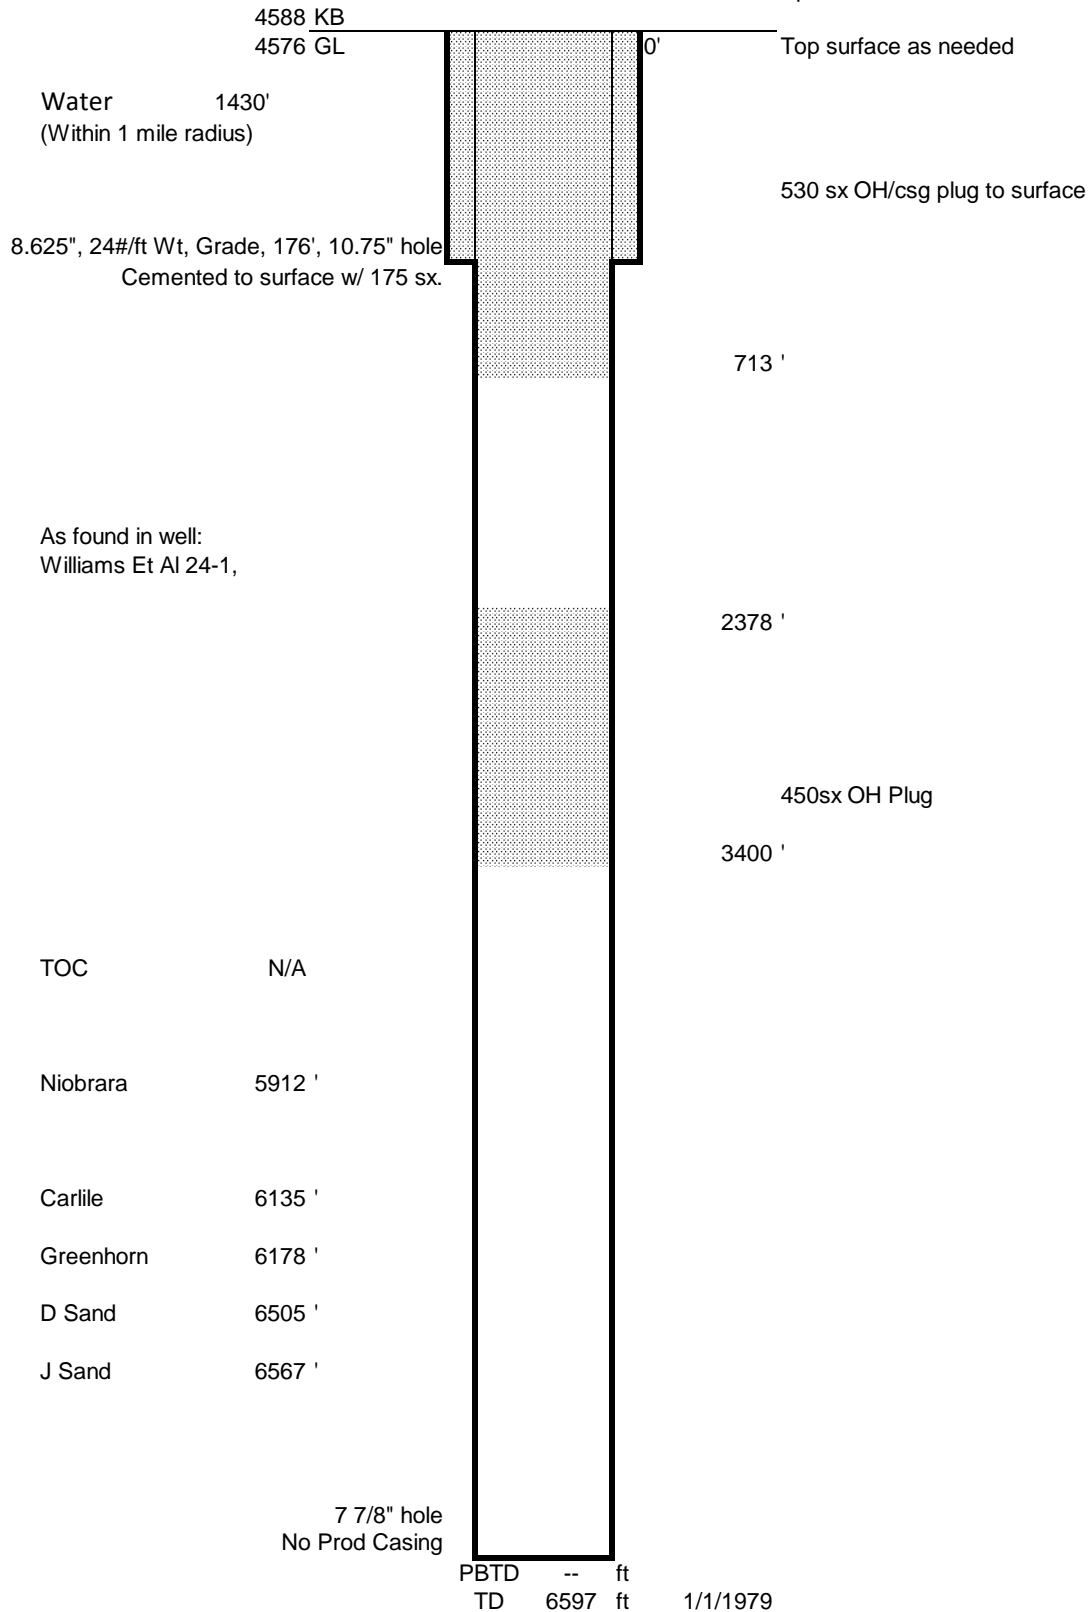

Updated 10/28/2014 jad