

Noble Energy

CO, Weld County (NAD 83 NZ)
Sec 4 Twn 6 N Rng 63 W
NCLP AA06-64-1AHNA Original Hole
05-123-39027
H&P 277



A Schlumberger Company

Final Survey Report

29-Oct-2014





Well Coordinates:	NAD83 CO State Plane, N Zone, US Feet
	N 40° 30' 52.41600" W 104° 27' 3.09600"
	1432020.39 usFt 3291695.78 usFt
Ground Level:	4711.00 ft MSL
TVD Reference:	KB 24ft @ 4735.00 ft MSL
Local Coordinate Origin:	NCLP AA06-64-1AHNA well head
Vertical Section Azimuth:	266.355 ° (Grid North)
North Reference:	Grid North

DOX Version: 2.8

Borehole:	Well:	Field:	Structure:
Original Hole	NCLP AA06-64-1AHNA	CO, Weld County (NAD 83 NZ)	Noble 04-06N-63W (NCLP AA06 64-65 Pad) - H&P 277

Gravity & Magnetic Parameters	Surface Location	Miscellaneous
Model: BGGM 2014 Dip: 67.079° Date: 26-Jul-2014	NAD83 Colorado State Plane, Northern Zone, US Feet	Slot: NCLP AA06-64-1AHNA TVD Ref: KB 24ft(4735ft above MSL)
MagDec: 8.367° FS: 52796.563nT Gravity FS: 999.066mgn (9.80665 Based)	Lat: N 40 30 52.42 Northing: 1432020.38ftUS Grid Conv: 0.6779°	Plan: NCLP AA06-64-1AHNA MWD+GYRO 0' to 16309' Definitive
	Lon: W 104 27 3.10 Easting: 3291695.78ftUS Scale Fact: 0.99996742	

PvA

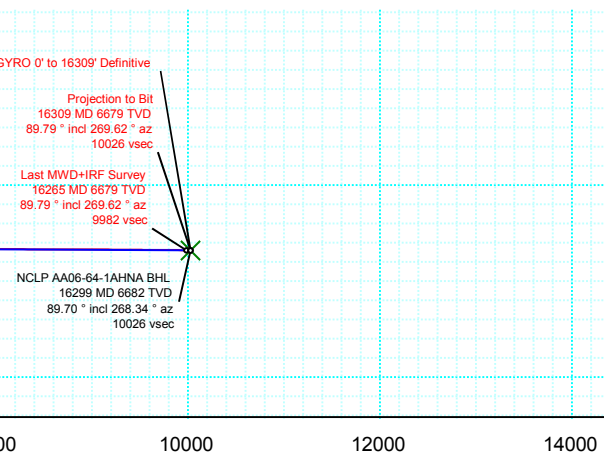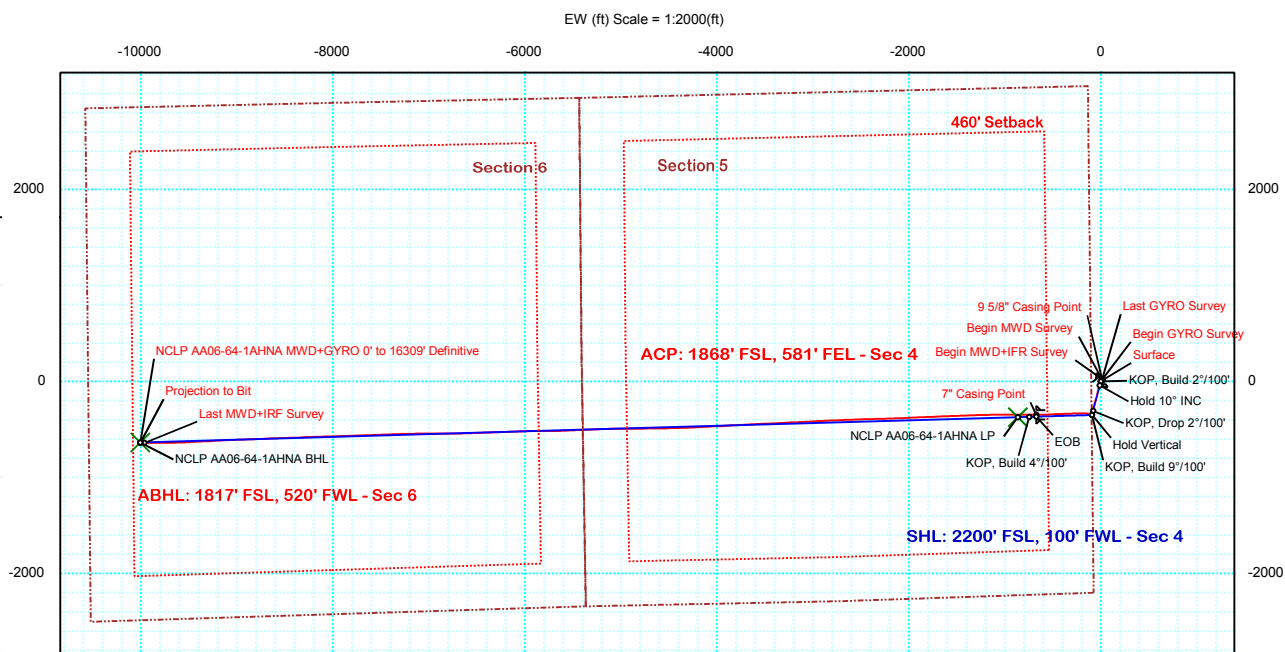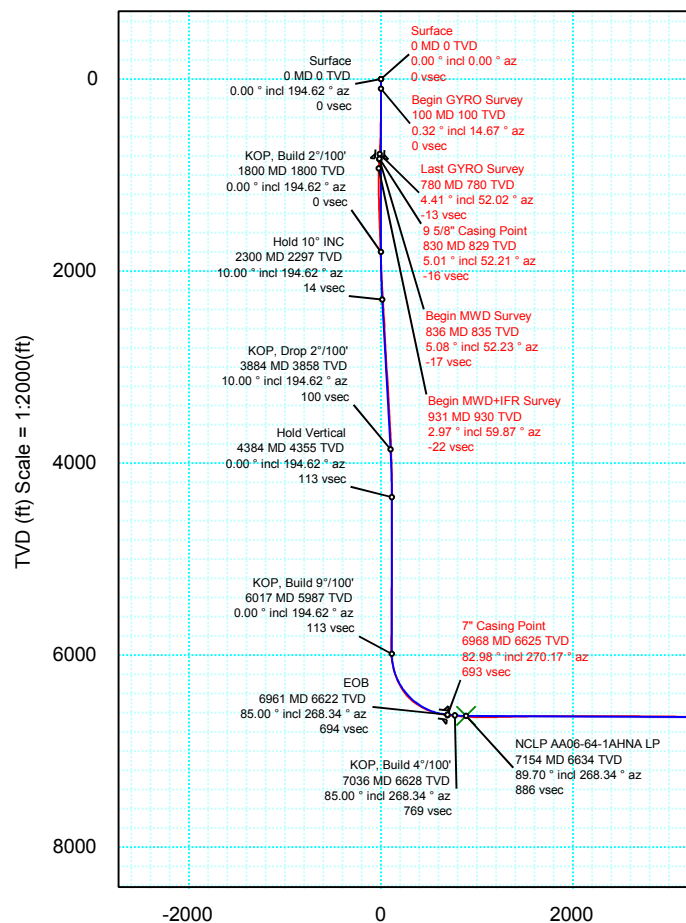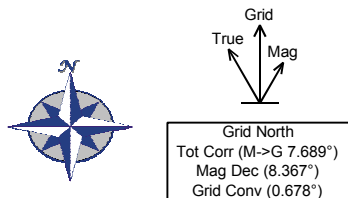



NCLP AA06-64-1AHNA MWD+GYRO 0' to 16309' Definitive Survey
Geodetic Report
(Def Survey)



Report Date: August 19, 2014 - 02:10 PM
Client: Noble Energy
Field: CO, Weld County (NAD 83 NZ)
Structure / Slot: Noble 04-06N-63W (NCLP AA06 64-65 Pad) - H&P 277 / NCLP AA06-64-1AHNA
Well: NCLP AA06-64-1AHNA
Borehole: Original Hole
UWI / API#: Unknown / Unknown
Survey Name: NCLP AA06-64-1AHNA MWD+GYRO 0' to 16309' Definitive
Survey Date: July 26, 2014
Tort / AHD / DDI / ERD Ratio: 185.459 ° / 10356.129 ft / 6.671 / 1.551
Coordinate Reference System: NAD83 Colorado State Plane, Northern Zone, US Feet
Location Lat / Long: N 40° 30' 52.41600", W 104° 27' 3.09600"
Location Grid N/E Y/X: N 1432020.385 ftUS, E 3291695.777 ftUS
CRS Grid Convergence Angle: 0.6779 °
Grid Scale Factor: 0.99996742
Version / Patch: 2.8.551.0

Survey / DLS Computation: Minimum Curvature / Lubinski
Vertical Section Azimuth: 266.355 ° (Grid North)
Vertical Section Origin: 0.000 ft, 0.000 ft
TVD Reference Datum: KB 24ft
TVD Reference Elevation: 4735.000 ft above MSL
Seabed / Ground Elevation: 4711.000 ft above MSL
Magnetic Declination: 8.367 °
Total Gravity Field Strength: 999.0659mgn (9.80665 Based)
Gravity Model: GARM
Total Magnetic Field Strength: 52796.563 nT
Magnetic Dip Angle: 67.079 °
Declination Date: July 26, 2014
Magnetic Declination Model: BGGM 2014
North Reference: Grid North
Grid Convergence Used: 0.6779 °
Total Corr Mag North->Grid North: 7.6887 °
Local Coord Referenced To: Well Head

Comments	MD (ft)	Incl (°)	Azim Grid (°)	TVD (ft)	VSEC (ft)	NS (ft)	EW (ft)	DLS (°/100ft)	Northing (ftUS)	Easting (ftUS)	Latitude (N/S ° ' ")	Longitude (E/W ° ' ")
Surface	0.00	0.00	0.00	0.00	0.00	0.00	0.00	N/A	1432020.39	3291695.78	N 40 30 52.42 W 104 27 3.10	3.10
Begin GYRO	100.00	0.32	14.67	100.00	-0.09	0.27	0.07	0.32	1432020.66	3291695.85	N 40 30 52.42 W 104 27 3.10	3.10
Survey	200.00	0.32	40.77	200.00	-0.37	0.75	0.32	0.14	1432021.14	3291696.10	N 40 30 52.42 W 104 27 3.09	3.09
	300.00	0.10	20.68	300.00	-0.60	1.04	0.54	0.23	1432021.43	3291696.31	N 40 30 52.43 W 104 27 3.09	3.09
	400.00	0.55	26.37	400.00	-0.88	1.56	0.78	0.45	1432021.94	3291696.56	N 40 30 52.43 W 104 27 3.09	3.09
	500.00	1.37	46.76	499.98	-2.04	2.81	1.87	0.88	1432023.19	3291697.64	N 40 30 52.44 W 104 27 3.07	3.07
	600.00	2.24	48.31	599.93	-4.50	4.92	4.20	0.87	1432025.31	3291699.97	N 40 30 52.46 W 104 27 3.04	3.04
	700.00	3.33	52.33	699.81	-8.45	8.00	7.95	1.11	1432028.38	3291703.73	N 40 30 52.49 W 104 27 2.99	2.99
Last GYRO	780.00	4.41	52.02	779.63	-12.91	11.31	12.22	1.35	1432031.70	3291707.99	N 40 30 52.53 W 104 27 2.94	2.94
Survey												
9 5/8" Casing	830.00	5.01	52.21	829.46	-16.31	13.83	15.46	1.20	1432034.22	3291711.23	N 40 30 52.55 W 104 27 2.89	2.89
Point												
MWD Survey	836.00	5.08	52.23	835.43	-16.74	14.16	15.87	1.20	1432034.54	3291711.65	N 40 30 52.55 W 104 27 2.89	2.89
Begin												
MWD+IFR	931.00	2.97	59.87	930.20	-22.43	17.97	21.33	2.29	1432038.35	3291717.10	N 40 30 52.59 W 104 27 2.82	2.82
Survey												
	1026.00	0.65	187.90	1025.16	-24.52	18.67	23.38	3.59	1432039.05	3291719.16	N 40 30 52.60 W 104 27 2.79	2.79
	1119.00	0.59	190.91	1118.15	-24.30	17.68	23.22	0.07	1432038.06	3291719.00	N 40 30 52.59 W 104 27 2.79	2.79
	1212.00	2.42	221.34	1211.12	-22.79	15.73	21.83	2.08	1432036.12	3291717.61	N 40 30 52.57 W 104 27 2.81	2.81
	1306.00	2.61	226.28	1305.03	-19.75	12.76	18.97	0.31	1432033.15	3291714.75	N 40 30 52.54 W 104 27 2.85	2.85
	1401.00	2.52	223.76	1399.93	-16.56	9.76	15.97	0.15	1432030.14	3291711.74	N 40 30 52.51 W 104 27 2.89	2.89
	1494.00	2.32	225.39	1492.85	-13.63	6.96	13.21	0.23	1432027.35	3291708.99	N 40 30 52.48 W 104 27 2.92	2.92
	1588.00	2.43	223.76	1586.77	-10.73	4.19	10.48	0.14	1432024.57	3291706.26	N 40 30 52.46 W 104 27 2.96	2.96
	1683.00	2.60	227.43	1681.68	-7.57	1.27	7.50	0.25	1432021.66	3291703.28	N 40 30 52.43 W 104 27 3.00	3.00
	1777.00	2.54	226.90	1775.58	-4.30	-1.59	4.41	0.07	1432018.79	3291700.19	N 40 30 52.40 W 104 27 3.04	3.04
	1872.00	4.41	208.63	1870.40	-0.72	-6.24	1.12	2.26	1432014.15	3291696.90	N 40 30 52.35 W 104 27 3.08	3.08
	1967.00	5.93	200.05	1965.02	3.20	-14.05	-2.31	1.79	1432006.33	3291693.47	N 40 30 52.28 W 104 27 3.13	3.13
	2061.00	6.06	199.22	2058.50	7.08	-23.30	-5.61	0.17	1431997.09	3291690.17	N 40 30 52.19 W 104 27 3.17	3.17
	2156.00	7.62	203.33	2152.82	11.88	-33.82	-9.75	1.72	1431986.57	3291686.02	N 40 30 52.08 W 104 27 3.23	3.23
	2251.00	9.09	199.15	2246.81	17.65	-46.69	-14.71	1.67	1431973.69	3291681.07	N 40 30 51.96 W 104 27 3.29	3.29
	2345.00	10.13	194.74	2339.50	23.13	-61.70	-19.25	1.35	1431958.68	3291676.53	N 40 30 51.81 W 104 27 3.35	3.35
	2440.00	9.74	194.65	2433.07	28.29	-77.56	-23.41	0.41	1431942.83	3291672.37	N 40 30 51.65 W 104 27 3.41	3.41
	2535.00	9.45	195.03	2526.74	33.31	-92.86	-27.46	0.31	1431927.52	3291668.31	N 40 30 51.50 W 104 27 3.47	3.47
	2629.00	9.54	193.92	2619.45	38.13	-107.88	-31.34	0.22	1431912.51	3291664.44	N 40 30 51.35 W 104 27 3.52	3.52
	2723.00	9.20	194.03	2712.20	42.77	-122.73	-35.03	0.36	1431897.66	3291660.74	N 40 30 51.21 W 104 27 3.57	3.57
	2818.00	10.34	192.75	2805.82	47.48	-138.41	-38.76	1.22	1431881.98	3291657.02	N 40 30 51.05 W 104 27 3.62	3.62
	2912.00	10.54	193.32	2898.26	52.37	-155.01	-42.60	0.24	1431865.38	3291653.18	N 40 30 50.89 W 104 27 3.67	3.67
	3007.00	10.86	195.85	2991.61	57.89	-172.07	-47.05	0.60	1431848.32	3291648.73	N 40 30 50.72 W 104 27 3.73	3.73
	3102.00	10.77	196.69	3084.93	63.96	-189.18	-52.04	0.19	1431831.21	3291643.74	N 40 30 50.55 W 104 27 3.80	3.80
	3196.00	10.90	197.95	3177.25	70.28	-206.05	-57.30	0.29	1431814.34	3291638.48	N 40 30 50.39 W 104 27 3.87	3.87
	3291.00	10.14	196.18	3270.65	76.43	-222.63	-62.40	0.87	1431797.77	3291633.38	N 40 30 50.22 W 104 27 3.94	3.94
	3386.00	9.82	194.68	3364.21	81.81	-238.49	-66.78	0.43	1431781.90	3291629.00	N 40 30 50.07 W 104 27 4.00	4.00
	3480.00	9.14	196.57	3456.93	86.91	-253.40	-70.94	0.80	1431766.99	3291624.84	N 40 30 49.92 W 104 27 4.05	4.05
	3575.00	9.35	192.84	3550.70	91.71	-268.16	-74.81	0.67	1431752.23	3291620.97	N 40 30 49.78 W 104 27 4.11	4.11
	3670.00	9.91	195.23	3644.36	96.54	-283.57	-78.67	0.72	1431736.82	3291617.11	N 40 30 49.62 W 104 27 4.16	4.16
	3764.00	8.45	196.06	3737.15	101.49	-298.02	-82.71	1.56	1431722.38	3291613.07	N 40 30 49.48 W 104 27 4.21	4.21
	3859.00	7.53	189.69	3831.23	105.28	-310.86	-85.69	1.34	1431709.54	3291610.09	N 40 30 49.35 W 104 27 4.25	4.25
	3953.00	6.40	186.73	3924.54	107.64	-322.13	-87.34	1.26	1431698.26	3291608.44	N 40 30 49.24 W 104 27 4.28	4.28
	4048.00	5.12	193.79	4019.06	109.86	-331.51	-88.97	1.54	1431688.89	3291606.81	N 40 30 49.15 W 104 27 4.30	4.30
	4143.00	3.50	201.50	4113.78	112.37	-338.32	-91.04	1.81	1431682.07	3291604.74	N 40 30 49.08 W 104 27 4.33	4.33
	4237.00	2.22	160.96	4207.67	113.10	-342.72	-91.50	2.46	1431677.68	3291604.28	N 40 30 49.04 W 104 27 4.33	4.33
	4332.00	0.48	26.09	4302.65	112.42	-344.10	-90.72	2.72	1431676.30	3291605.06	N 40 30 49.03 W 104 27 4.32	4.32
	4426.00	0.56	8.57	4396.65	112.12	-343.29	-90.48	0.19	1431677.11	3291605.30	N 40 30 49.03 W 104 27 4.32	4.32
	4521.00	0.51	347.50	4491.65	112.09	-342.42	-90.50	0.21	1431677.98	3291605.28	N 40 30 49.04 W 104 27 4.32	4.32
	4616.00	0.69	317.00	4586.64	112.52	-341.59	-90.99	0.38	1431678.81	3291604.79	N 40 30 49.05 W 104 27 4.33	4.33
	4711.00	0.59	278.42	4681.63	113.36	-341.10	-91.86	0.46	1431679.30	3291603.92	N 40 30 49.06 W 104 27 4.34	4.34
	4805.00	0.63	253.46	4775.63	114.34	-341.17	-92.83	0.28	1431679.22	3291602.95	N 40 30 49.06 W 104 27 4.35	4.35
	4900.00	0.35	147.60	4870.63	114.71	-341.57	-93.18	0.84	1431678.83	3291602.60	N 40 30 49.05 W 104 27 4.35	4.35
	4995.00	0.37	141.58	4965.63	114.39	-342.05	-92.83	0.05	1431678.34	3291602.95	N 40 30 49.05 W 104 27 4.35	4.35
	5090.00	0.48	138.44	5060.62	113.97	-342.59	-92.38	0.12	1431677.81	3291603.40	N 40 30 49.04 W 104 27 4.34	4.34
	5185.00	0.58	133.51	5155.62	113.40	-343.22	-91.77	0.12	1431677.18	3291604.01	N 40 30 49.04 W 104 27 4.34	4.34
	5279.00	0.83	127.29	5249.61	112.56	-343.96	-90.88	0.28	1431676.44	3291604.90	N 40 30 49.03 W 104 27 4.33	4.33
	5374.00	0.71	101.11	5344.60	111.47	-344.49	-89.75	0.39	1431675.91	3291606.03	N 40 30 49.02 W 104 27 4.31	4.31
	5469.00	0.53	72.50	5439.60	110.48	-344.47	-88.76	0.37	1431675.93	3291607.02	N 40 30 49.02 W 104 27 4.30	4.30
	5564.00	0.14	78.72	5534.60	109.94	-344.32	-88.22	0.41	1431676.08	3291607.55	N 40 30 49.02 W 104 27 4.29	4.29
	5658.00	0.56	43.89	5628.59	109.48	-343.96	-87.79	0.48	1431676.43	3291607.99	N 40 30 49.03 W 104 27 4.29	4.29
	5753.00	0.36	34.80	5723.59	108.96	-343.38	-87.30	0.22	1431677.01	3291608.48	N 40 30 49.03 W 104 27 4.28	4.28
	5848.00	0.40	38.09	5818.59	108.55	-342.88	-86.93	0.05	1431677.52	3291608.85	N 40 30 49.04 W 104 27 4.27	4.27
	5942.00	0.51	44.84	5912.59	108.02	-342.32	-86.43	0.13	1431678.07	3291609.35	N 40 30 49.04 W 104 27 4.27	4.27
	6035.00	3.49	287.44	6005.53	110.35	-341.18	-88.84	4.03	1431679.22	3291606.94	N 40 30 49.06 W 104 27 4.30	4.30
	6129.00	11.22	278.71	6098.69	121.96	-338.93	-100.62	8.29	1431681.46	3291595.16	N 40 30 49.08 W 104 27 4.45	4.45
	6224.00	18.17	274.77	6190.53	145.68	-336.30	-124.55	7.39	1431684.10	3291571.23	N 40 30 49.11 W 104 27 4.76	4.76
	6319.00	24.80	272.25	6278.88	180.19	-334.28	-159.26	7.03				

Comments	MD (ft)	Incl (°)	Azim Grid (°)	TVD (ft)	VSEC (ft)	NS (ft)	EW (ft)	DLS (°/100ft)	Northing (ftUS)	Easting (ftUS)	Latitude (N/S ° ' ")	Longitude (E/W ° ' ")
7" Casing Point	6792.00	70.04	266.86	6586.52	521.59	-342.83	-500.80	8.73	1431677.56	3291194.99	N 40 30 49.09 W 104 27 9.63	
	6887.00	78.25	267.47	6612.45	612.88	-347.34	-592.00	8.67	1431673.05	3291103.80	N 40 30 49.05 W 104 27 10.81	
	6919.00	80.85	268.67	6618.25	644.34	-348.40	-623.45	8.92	1431671.99	3291072.35	N 40 30 49.05 W 104 27 11.22	
	6968.00	82.98	270.17	6625.14	692.78	-348.89	-671.95	5.30	1431671.51	3291023.85	N 40 30 49.05 W 104 27 11.85	
	7002.00	84.46	271.21	6628.86	726.47	-348.48	-705.75	5.30	1431671.91	3290990.05	N 40 30 49.06 W 104 27 12.29	
	7097.00	85.18	270.66	6637.44	820.78	-346.94	-800.34	0.95	1431673.45	3290895.46	N 40 30 49.08 W 104 27 13.51	
	7192.00	87.08	270.08	6643.85	915.33	-346.33	-895.12	2.09	1431674.07	3290800.69	N 40 30 49.10 W 104 27 14.74	
	7287.00	88.97	269.71	6647.13	1010.09	-346.50	-990.06	2.03	1431673.89	3290705.75	N 40 30 49.11 W 104 27 15.97	
	7381.00	90.93	269.25	6647.22	1103.94	-347.36	-1084.05	2.14	1431673.04	3290611.76	N 40 30 49.11 W 104 27 17.18	
	7476.00	91.44	268.81	6645.25	1198.82	-348.97	-1179.02	0.71	1431671.43	3290516.80	N 40 30 49.11 W 104 27 18.41	
	7571.00	91.20	268.12	6643.05	1293.73	-351.51	-1273.96	0.77	1431668.88	3290421.86	N 40 30 49.09 W 104 27 19.64	
	7666.00	91.03	268.12	6641.20	1388.66	-354.63	-1368.89	0.18	1431665.77	3290326.94	N 40 30 49.07 W 104 27 20.87	
	7760.00	91.10	267.81	6639.45	1482.61	-357.96	-1462.81	0.34	1431662.44	3290233.02	N 40 30 49.05 W 104 27 22.09	
	7855.00	90.76	267.82	6637.92	1577.57	-361.58	-1557.73	0.36	1431658.82	3290138.10	N 40 30 49.02 W 104 27 23.32	
	7949.00	90.38	267.57	6636.98	1671.54	-365.35	-1651.65	0.48	1431655.04	3290044.18	N 40 30 49.00 W 104 27 24.53	
	8044.00	90.00	267.88	6636.67	1766.51	-369.12	-1746.57	0.52	1431651.28	3289949.26	N 40 30 48.97 W 104 27 25.76	
	8139.00	89.69	267.66	6636.93	1861.48	-372.81	-1841.50	0.40	1431647.59	3289854.34	N 40 30 48.95 W 104 27 26.99	
	8233.00	89.42	267.58	6637.66	1955.45	-376.71	-1935.42	0.31	1431643.69	3289760.43	N 40 30 48.92 W 104 27 28.21	
	8328.00	89.86	267.55	6638.26	2050.43	-380.75	-2030.33	0.47	1431639.65	3289665.52	N 40 30 48.89 W 104 27 29.44	
	8423.00	90.14	267.80	6638.26	2145.40	-384.60	-2125.25	0.39	1431635.79	3289570.60	N 40 30 48.86 W 104 27 30.67	
	8518.00	90.03	267.87	6638.12	2240.37	-388.19	-2220.18	0.13	1431632.21	3289475.67	N 40 30 48.84 W 104 27 31.90	
	8613.00	90.62	268.59	6637.57	2335.32	-391.13	-2315.14	0.98	1431629.27	3289380.72	N 40 30 48.82 W 104 27 33.13	
	8707.00	90.31	268.79	6636.81	2429.24	-393.28	-2409.11	0.39	1431627.11	3289286.75	N 40 30 48.81 W 104 27 34.35	
	8802.00	89.59	268.14	6636.90	2524.17	-395.83	-2504.07	1.02	1431624.57	3289191.79	N 40 30 48.80 W 104 27 35.57	
	8897.00	89.48	268.16	6637.67	2619.12	-398.89	-2599.02	0.11	1431621.51	3289096.85	N 40 30 48.78 W 104 27 36.80	
	8991.00	89.21	267.07	6638.74	2713.09	-402.80	-2692.93	1.20	1431617.60	3288902.94	N 40 30 48.75 W 104 27 38.02	
	9086.00	89.90	267.49	6639.48	2808.08	-407.30	-2787.82	0.85	1431613.10	3288908.05	N 40 30 48.72 W 104 27 39.25	
	9181.00	90.14	267.78	6639.45	2903.05	-411.22	-2882.74	0.39	1431609.18	3288813.14	N 40 30 48.69 W 104 27 40.48	
	9276.00	89.17	266.80	6640.02	2998.03	-415.71	-2977.63	1.45	1431604.69	3288718.23	N 40 30 48.65 W 104 27 41.71	
	9370.00	88.59	266.49	6641.86	3092.02	-421.22	-3071.45	0.71	1431599.18	3288624.43	N 40 30 48.61 W 104 27 42.92	
	9465.00	89.93	267.26	6643.08	3187.00	-426.40	-3166.30	1.63	1431594.00	3288529.59	N 40 30 48.57 W 104 27 44.15	
	9560.00	90.10	267.43	6643.05	3281.99	-430.79	-3261.20	0.25	1431589.61	3288434.69	N 40 30 48.54 W 104 27 45.38	
	9655.00	90.10	267.31	6642.88	3376.97	-435.15	-3356.10	0.13	1431585.25	3288339.80	N 40 30 48.51 W 104 27 46.61	
	9749.00	90.45	267.59	6642.43	3470.95	-439.34	-3450.00	0.47	1431581.06	3288245.90	N 40 30 48.48 W 104 27 47.83	
	9844.00	90.34	267.34	6641.78	3565.93	-443.54	-3544.91	0.28	1431576.86	3288150.99	N 40 30 48.45 W 104 27 49.06	
	9939.00	90.82	266.98	6640.81	3660.92	-448.25	-3639.78	0.64	1431572.15	3288056.12	N 40 30 48.41 W 104 27 50.29	
	10034.00	90.45	266.77	6639.75	3755.91	-453.43	-3734.64	0.45	1431566.97	3287961.27	N 40 30 48.37 W 104 27 51.51	
	10129.00	89.79	266.99	6639.55	3850.90	-458.60	-3829.49	0.73	1431561.80	3287866.41	N 40 30 48.33 W 104 27 52.74	
	10223.00	89.73	267.07	6639.95	3944.90	-463.47	-3923.37	0.11	1431556.94	3287772.54	N 40 30 48.29 W 104 27 53.96	
	10318.00	89.83	267.04	6640.32	4039.89	-468.34	-4018.24	0.11	1431552.06	3287677.67	N 40 30 48.25 W 104 27 55.19	
	10413.00	89.66	266.91	6640.75	4134.88	-473.36	-4113.11	0.23	1431547.04	3287582.81	N 40 30 48.22 W 104 27 56.42	
	10508.00	89.93	267.14	6641.09	4229.87	-478.29	-4207.98	0.38	1431542.11	3287487.94	N 40 30 48.18 W 104 27 57.65	
	10602.00	89.42	267.74	6641.62	4323.85	-482.49	-4301.88	0.84	1431537.91	3287394.04	N 40 30 48.15 W 104 27 58.86	
	10697.00	89.45	268.23	6642.56	4418.81	-485.83	-4396.82	0.52	1431534.57	3287299.11	N 40 30 48.13 W 104 28 0.09	
	10791.00	89.14	268.83	6643.72	4512.74	-488.24	-4490.78	0.72	1431532.16	3287205.15	N 40 30 48.11 W 104 28 1.31	
	10885.00	89.00	269.19	6645.24	4606.62	-489.86	-4584.75	0.41	1431530.55	3287111.18	N 40 30 48.11 W 104 28 2.53	
	10979.00	89.55	269.17	6646.42	4700.50	-491.20	-4678.74	0.59	1431529.20	3287017.20	N 40 30 48.11 W 104 28 3.74	
	11074.00	89.76	269.66	6646.99	4795.36	-492.16	-4773.73	0.56	1431528.24	3286922.21	N 40 30 48.11 W 104 28 4.97	
	11168.00	89.35	269.64	6647.73	4889.20	-492.73	-4867.73	0.44	1431527.67	3286828.22	N 40 30 48.11 W 104 28 6.19	
	11260.00	89.38	269.87	6648.75	4981.04	-493.13	-4959.72	0.25	1431527.27	3286736.23	N 40 30 48.12 W 104 28 7.38	
	11355.00	89.79	269.05	6649.43	5075.89	-494.02	-5054.71	0.96	1431526.38	3286641.24	N 40 30 48.12 W 104 28 8.61	
	11449.00	89.52	268.26	6649.99	5169.81	-496.23	-5148.68	0.90	1431524.17	3286547.27	N 40 30 48.11 W 104 28 9.83	
	11542.00	89.55	267.63	6650.75	5262.78	-499.56	-5241.62	0.67	1431520.84	3286454.34	N 40 30 48.09 W 104 28 11.03	
	11636.00	89.45	267.80	6651.57	5356.75	-503.31	-5335.54	0.21	1431517.09	3286360.42	N 40 30 48.06 W 104 28 12.25	
	11728.00	89.48	267.61	6652.42	5448.72	-506.99	-5427.46	0.21	1431513.41	3286268.50	N 40 30 48.04 W 104 28 13.44	
	11821.00	89.66	267.32	6653.12	5541.70	-511.10	-5520.37	0.36	1431509.30	3286175.60	N 40 30 48.01 W 104 28 14.64	
	11916.00	89.07	267.84	6654.17	5636.67	-515.12	-5615.28	0.83	1431505.29	3286080.69	N 40 30 47.98 W 104 28 15.87	
	12011.00	89.31	269.68	6655.51	5731.57	-517.17	-5710.24	1.95	1431503.23	3285985.73	N 40 30 47.97 W 104 28 17.10	
	12106.00	89.24	269.78	6656.71	5826.40	-517.62	-5805.23	0.13	1431502.78	3285890.74	N 40 30 47.97 W 104 28 18.33	
	12201.00	89.28	269.87	6657.93	5921.22	-517.91	-5900.23	0.10	1431502.49	3285795.76	N 40 30 47.98 W 104 28 19.56	
	12295.00	89.52	268.51	6658.92	6015.09	-519.24	-5994.21	1.47	1431501.16	3285701.78	N 40 30 47.98 W 104 28 20.78	
	12390.00	89.24	267.99	6659.94	6110.04	-522.15	-6089.16	0.62	1431498.25	3285606.83	N 40 30 47.96 W 104 28 22.01	
	12485.00	89.31	267.72	6661.14	6205.00	-525.71	-6184.08	0.29	1431494.69	3285511.91	N 40 30 47.94 W 104 28 23.24	
	12580.00	89.45	267.92	6662.16	6299.96	-529.32	-6279.01	0.26	1431491.08	3285416.98	N 40 30 47.91 W 104 28 24.47	
	12675.00	89.24	267.99	6663.25	6394.92	-532.71	-6373.94	0.23	1431487.69	3285322.05	N 40 30 47.89 W 104 28 25.70	
	12770.00	89.45	267.77	6664.33	6489.88	-536.22	-6468.87	0.32	1431484.18	3285227.13	N 40 30 47.87 W 104 28 26.93	
	12864.00	89.66	267.88	6665.06	6583.84	-539.78	-6562.80	0.25	1431480.62	3285133.20	N 40 30 47.84 W 104 28 28.14	
	12959.00	89.83	269.27	6665.49	6678.77	-542.15	-6657.77	1.47	1431478.26	3285038.24	N 40 30 47.83 W 104 28 29.37	
	13054.00	89.86	269.51	6665.74	6773.63	-543.16	-6752.76	0.26	1431477.24	3284943.25	N 40 30 47.83 W 104 28 30.60	
	13149.00	90.00	269.71	6665.86	6868.48	-543.81	-6847.76	0.25	1431476.59	3284848.25	N 40 30 47.83 W 104 28 31.83	
	13243.00	89.83	269.87	6666.00	6962.31	-544.16	-6941.76	0.25	1431476.24	3284754.26	N 40 30 47.84 W 104 28 33.05	
	13338.00	89.76	269.82	6666.34	7057.13	-544.42	-7036.76	0.09	1431475.99	3284659.26	N 40 30 47.85 W 104 28 34.28	
	13432.00	90.38	269.38	6666.23	7150.98	-545.07	-7130.76	0.81	1431475.33	3284565.27	N 40 30 47.85 W 104 28 35.50	
	13526.00	90.31	268.87	6665.67	7244.87	-546.51	-7224.74	0.55	1431473.90	3284471.28	N 40 30 47.85 W 104 28 36.71	
</												

Comments	MD (ft)	Incl (°)	Azim Grid (°)	TVD (ft)	VSEC (ft)	NS (ft)	EW (ft)	DLS (°/100ft)	Northing (ftUS)	Easting (ftUS)	Latitude (N/S ° ' ")	Longitude (E/W ° ' ")
Survey Type:	Def Survey											

Survey Error Model: ISCWSA Rev 0 *** 3-D 95.000% Confidence 2.7955 sigma
Survey Program:

Description	Part	MD From (ft)	MD To (ft)	EOU Freq (ft)	Hole Size	Casing Diameter (in)	Survey Tool Type	Borehole / Survey
Surface	1	0.000	24.000	1/98.425	13.750	9.625	SLB_NSG+MSHOT-Depth Only	Original Hole / NCLP AA06-64-1AHNA MWD+GYRO 0' to 16309' Definitive
Surface	1	24.000	780.000	Act Stns	13.750	9.625	SLB_NSG+MSHOT	Original Hole / NCLP AA06-64-1AHNA MWD+GYRO 0' to 16309'
Intermediate	1	780.000	836.000	Act Stns	13.750	9.625	SLB_INC_ONLY<10	Original Hole / NCLP AA06-64-1AHNA MWD+GYRO 0' to 16309'
* Intermediate	1	836.000	6968.000	Act Stns	8.750	7.000	SLB_MWD+IFR+DMAG	Original Hole / NCLP AA06-64-1AHNA MWD+GYRO 0' to 16309'
* Lateral	1	6968.000	16265.000	Act Stns	6.125	4.500	SLB_MWD+IFR+DMAG	Original Hole / NCLP AA06-64-1AHNA MWD+GYRO 0' to 16309'
Bit Projection	1	16265.000	16309.000	Act Stns	6.125	4.500	SLB_BLIND+TREND	Original Hole / NCLP AA06-64-1AHNA MWD+GYRO 0' to 16309'

* SLB_MWD+IFR+DMAG =
MWD+IFR1+MS_WY