


# Behring #1

660 FNL1980 FEL NWNE 12 5N 61W 6th PM  
 Lat 40.42145 Long -104.15387 (from footages)  
 Weld County, Colorado  
 API #05-123-09426

Spud date 3/22/1978

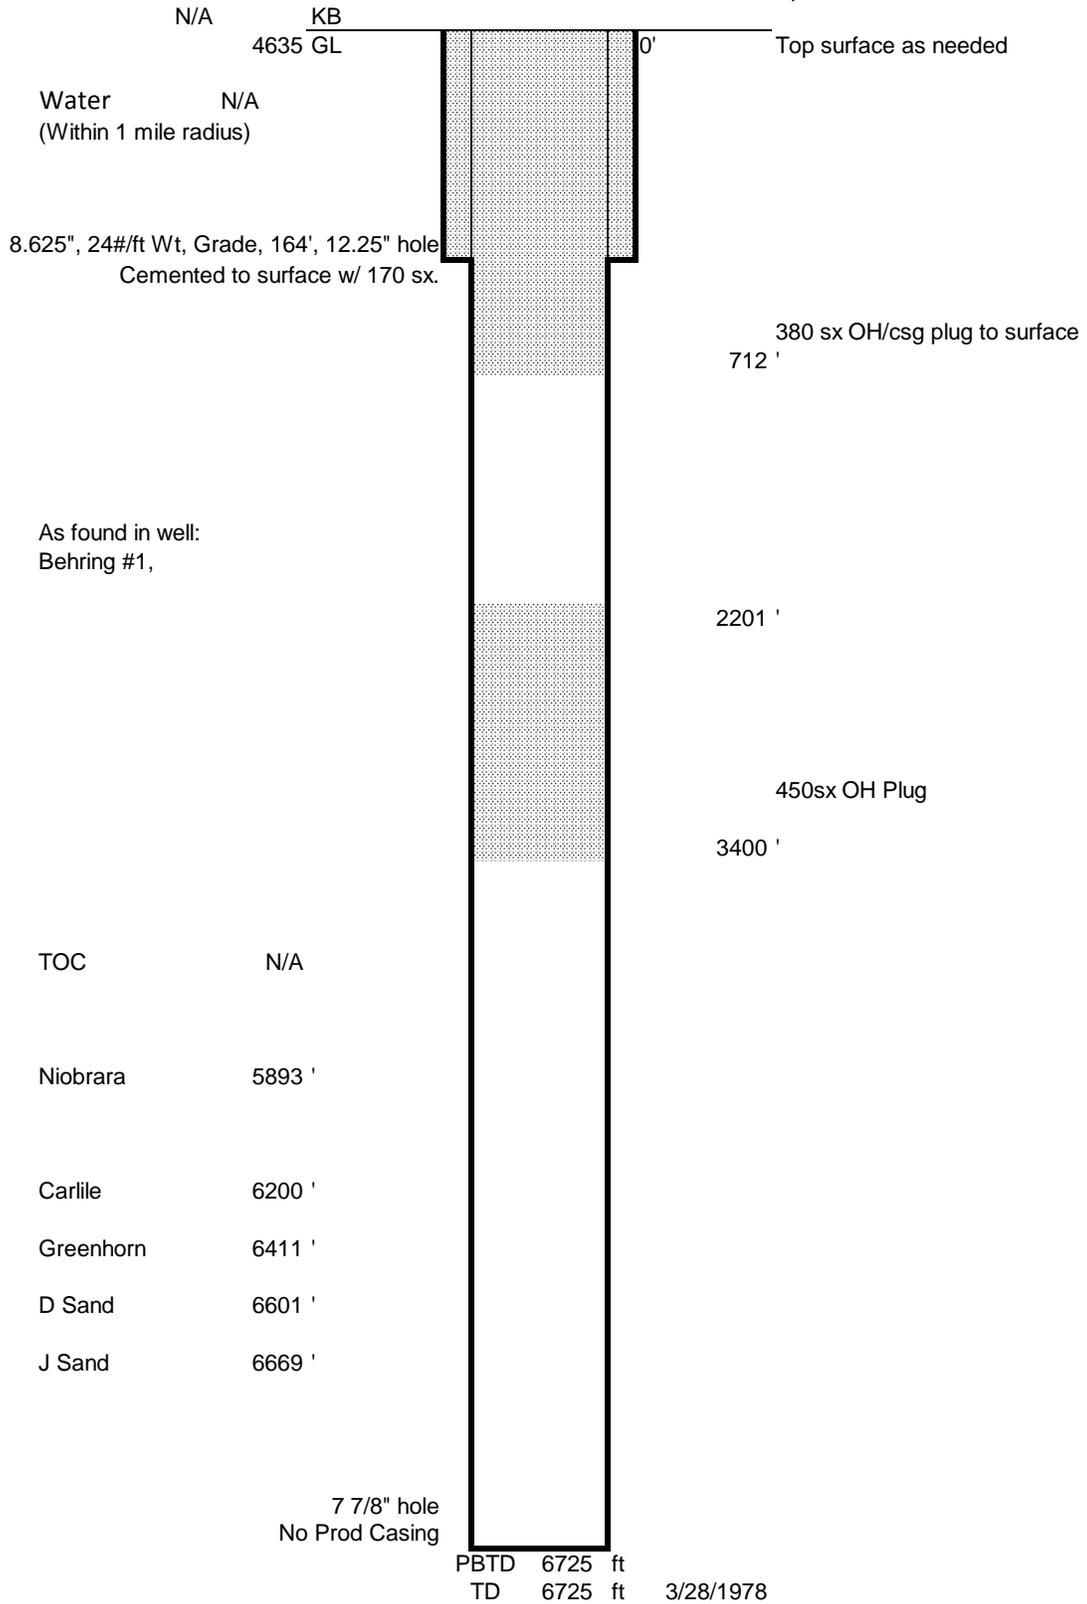

Updated 6/30/2014 jad

3/28/1978