



**LEGEND**

- ◆ ~ FOUND ORIGINAL STONE
- ⊙ ~ FOUND GLO BRASS CAP ON STEEL POST
- ⊕ ~ FOUND MONUMENT SET BY OTHERS AS NOTED
- ~ SET MONUMENT AS NOTED
- ~ WELL HEAD
- (M) ~ MEASURED IN FIELD
- └ ~ 90° SYMBOL
- WC ~ WITNESS CORNER

**BASIS OF BEARING:**

THE LINE FROM THE W1/4 CORNER TO THE NW CORNER OF SECTION 12, TOWNSHIP 11 SOUTH, RANGE 90 WEST, 6TH P.M., WAS ASSUMED TO BEAR N. 0°02'50" W. AS MONUMENTED AND SHOWN HEREON.

**CERTIFICATE OF SURVEY:**

I, David G. Nicewicz, a Registered Land Surveyor in the State of Colorado, do hereby certify that the survey represented by this plat was made under my direction and supervision, and that this plat accurately represents this survey.


David G. Nicewicz P.L.S. No. 24963  
(for and on behalf of URS Corporation)



**GAS WELL LOCATION PLAT**


FALCON SEABOARD 11-90-12 #5  
SURFACE LOCATION  
Located in the SW 1/4 Section 12, T. 11 S., R. 90 W.,  
6th P.M., Gunnison County, Colorado

SURVEYED BY: DGN	DWG DATE: 01/14/15	<b>David G. Nicewicz, PLS</b> <small>cell: (720) 456-1104 david.nicewicz@urs.com</small>
DRAFTED BY: MLD	SCALE: 1" = 1000'	
JOB NO.: 22243490.14000		SHEET NO. 1 of 2

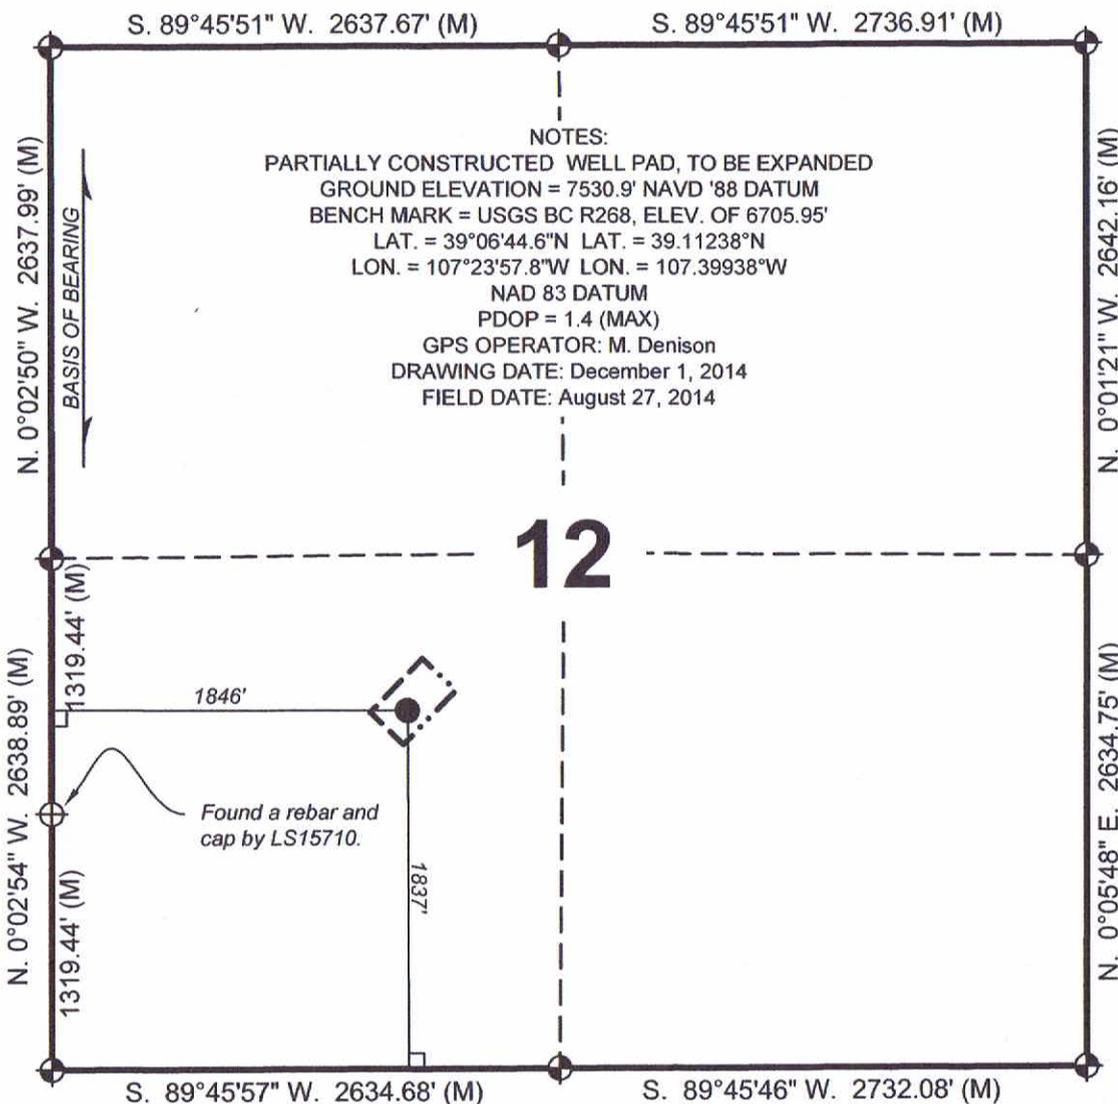

**NOTES:**  
PARTIALLY CONSTRUCTED WELL PAD, TO BE EXPANDED  
GROUND ELEVATION = 7530.9' NAVD '88 DATUM  
BENCH MARK = USGS BC R268, ELEV. OF 6705.95'  
LAT. = 39°06'44.6"N LAT. = 39.11238°N  
LON. = 107°23'57.8"W LON. = 107.39938°W  
NAD 83 DATUM  
PDOP = 1.4 (MAX)  
GPS OPERATOR: M. Denison  
DRAWING DATE: December 1, 2014  
FIELD DATE: August 27, 2014

URS CORP. OF GLENWOOD SPRINGS COLORADO, has in accordance with a request from ERIC SANFORD, for SG INTERESTS I, LTD, determined the location of FALCON SEABOARD 11-90-12 #5 SURFACE LOCATION to be 1846 FWL & 1837 FSL Section 12, Township 11 South, Range 90 West, of the Sixth Principal Meridian, Gunnison County, Colorado.

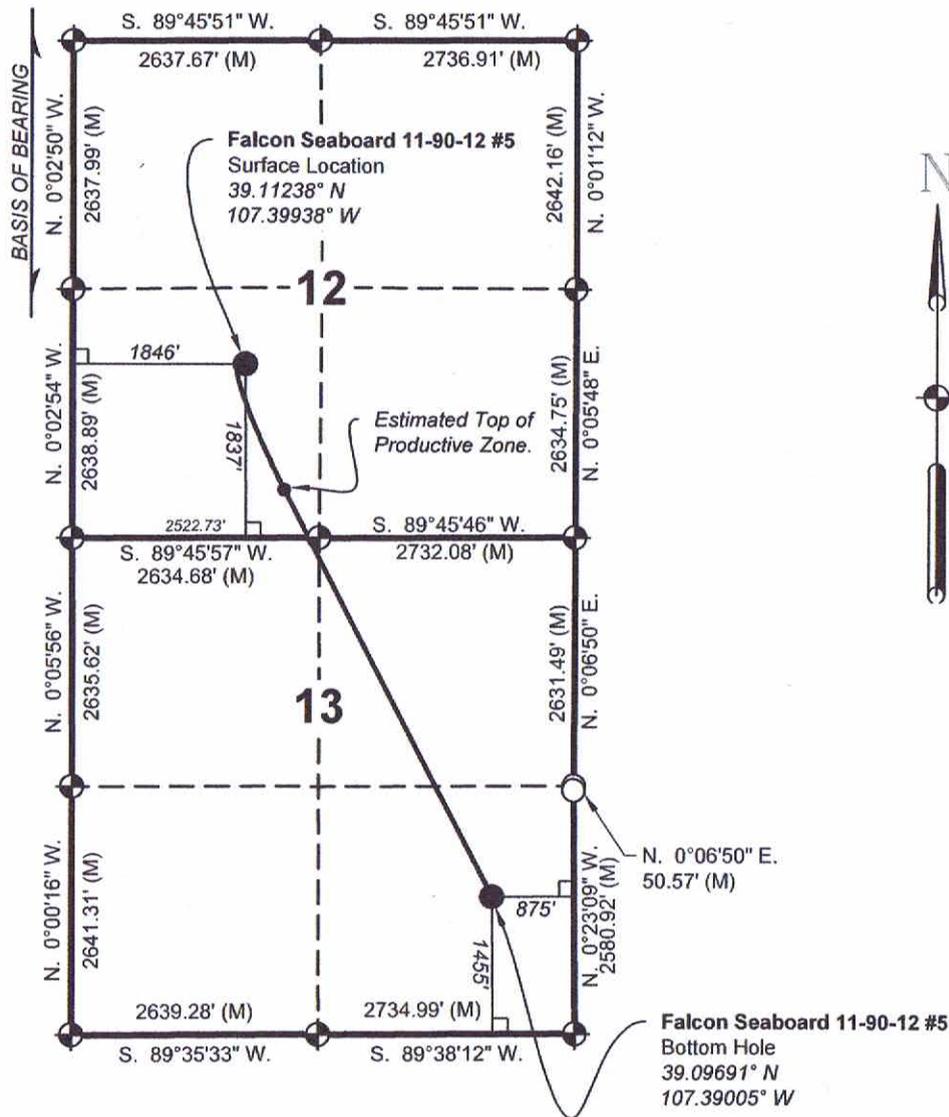

**LEGEND**

- ◆ - FOUND ORIGINAL STONE
- ⊙ - FOUND GLO BRASS CAP ON STEEL POST
- ⊕ - FOUND MONUMENT SET BY OTHERS AS NOTED
- - FOUND No.6 REBAR WITH A 2 1/2" ALUMINUM CAP, LS24963
- - WELL HEAD
- (M) - MEASURED IN FIELD
- L - 90° SYMBOL
- WC - WITNESS CORNER

**BASIS OF BEARING:**

THE LINE FROM THE W1/4 CORNER TO THE NW CORNER OF SECTION 12, TOWNSHIP 11 SOUTH, RANGE 90 WEST, 6TH P.M., WAS ASSUMED TO BEAR N. 0°02'50" W. AS MONUMENTED AND SHOWN HEREON.

**CERTIFICATE OF SURVEY:**

I, David G. Nicewicz, a Registered Land Surveyor in the State of Colorado, do hereby certify that the survey represented by this plat was made under my direction and supervision, and that this plat accurately represents this survey.

David G. Nicewicz P.L.S. No. 24963  
(for and on behalf of URS Corporation)



**GAS WELL LOCATION PLAT**

**FALCON SEABOARD 11-90-12 #5  
BOTTOM HOLE LOCATION**  
Located in the SE 1/4 Section 13, T. 11 S., R. 90 W.,  
6th P.M., Gunnison County, Colorado

SURVEYED BY: DGN	DWG DATE: 01/05/2015	<b>David G. Nicewicz, PLS</b>
DRAFTED BY: MLD	SCALE: 1" = 2000'	
JOB NO.: 22243490.14000		SHEET NO. 2 of 2

URS CORP. OF GLENWOOD SPRINGS COLORADO, has in accordance with a request from ERIC SANFORD, for SG INTERESTS I, LTD, determined the location of **FALCON SEABOARD 11-90-12 #5 BOTTOM HOLE LOCATION** to be 1455 FSL & 875 FEL Section 13, Township 11 South, Range 90 West, of the Sixth Principal Meridian, Gunnison County, Colorado.

URS Corp.  
904 Colorado Ave, Suite 201  
Glenwood Springs Co 81610  
cell: (720) 456-1104  
david.nicewicz@urs.com