Wellbore DiagramF W Terrell MV Gas Unit #1CSE Sec. 7, T33N, R8WLa Plata County, COAPI #05-067-05467

Final

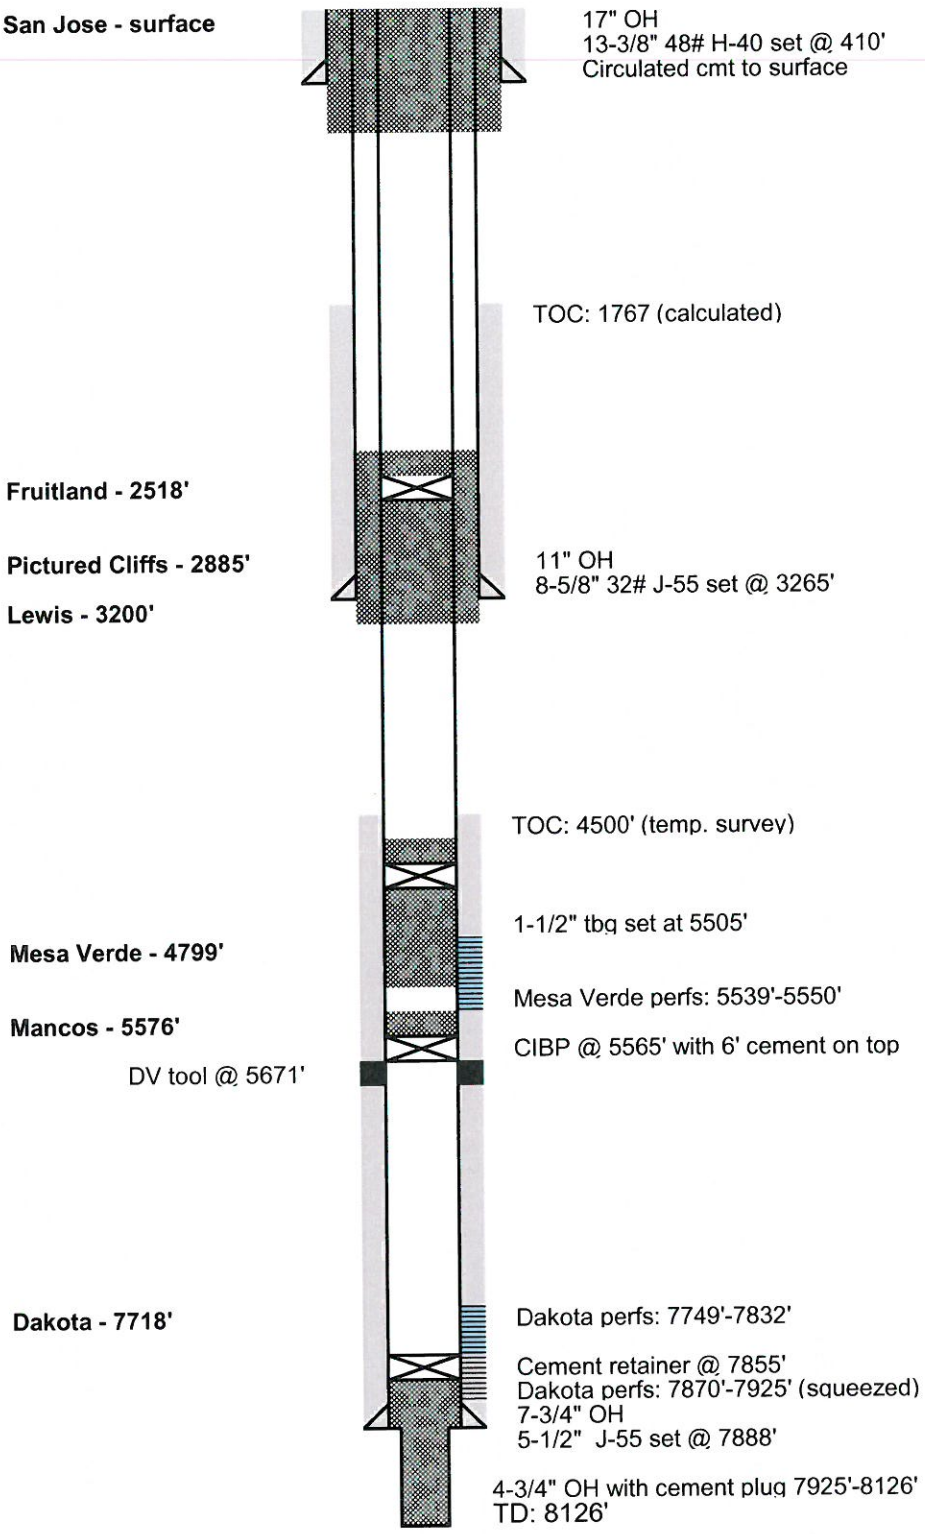

FW Terrell WBD2/2/2015