Wellbore DiagramUte #2NWSW Sec. 17, T33N, R9WLa Plata County, COAPI #05-067-06381

Final

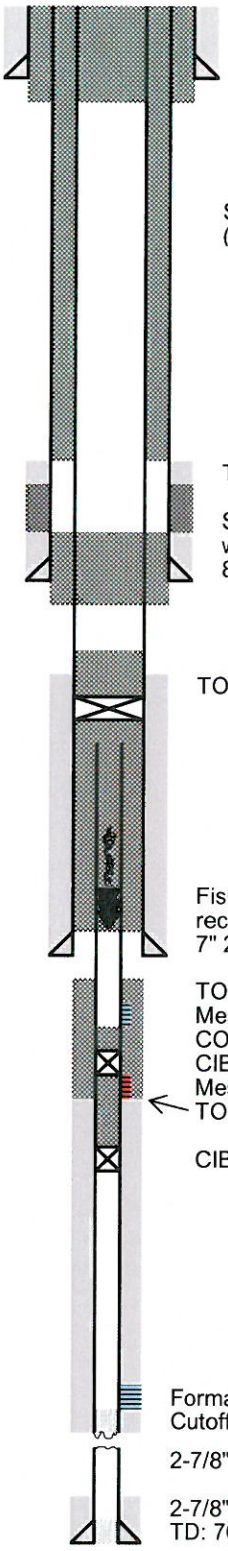

Nacimiento - surface

13-3/8" 48# H-40 set @ 308'
Circulated cmt to surface

Sqz'd casing leak (1209-1270') in 7" with 200 sx
(2613' fillup in 7"x8-5/8" annulus)

Fruitland - 2168'

Pictured Cliffs - 2624'

TOC: 2528' (calculated)

Sqz'd collapsed casing at 2650-68' in 8-5/8"
with 200 sx
8-5/8" 24# K-55 set @ 3050'

TOC: 3648' (calculated)

Mesa Verde - 4322'

Fish stuck @ 4700' with 350' of wireline on top -
recovery attempt unsuccessful
7" 23/25.6# K-55/N-80 set at 4729'

Pt. Lookout - 5036'
Mancos - 5144'

TOC: 4950' (CBL after sqz)
Mesa Verde perfs 5050'-5146'
COTD: 5143'
CIBP @ 5211'
Mesa Verde perfs 5221-23' sqz'd with 200 sx.
TOC: 5277' (CBL after primary cement job)

CIBP @ 5540'

Formation test perforations: 7044'-7058'
Cutoff PBTD at 7139'

2-7/8" casing cut off at 7175'

Dakota - 7420'
Morrison - 7638'

2-7/8" casing set at 7411'
TD: 7690'