


Wellbore Diagram
Smith-Ute #1
SESW Sec. 10, T33N, R9W
La Plata County, CO
API #05-067-05460

After

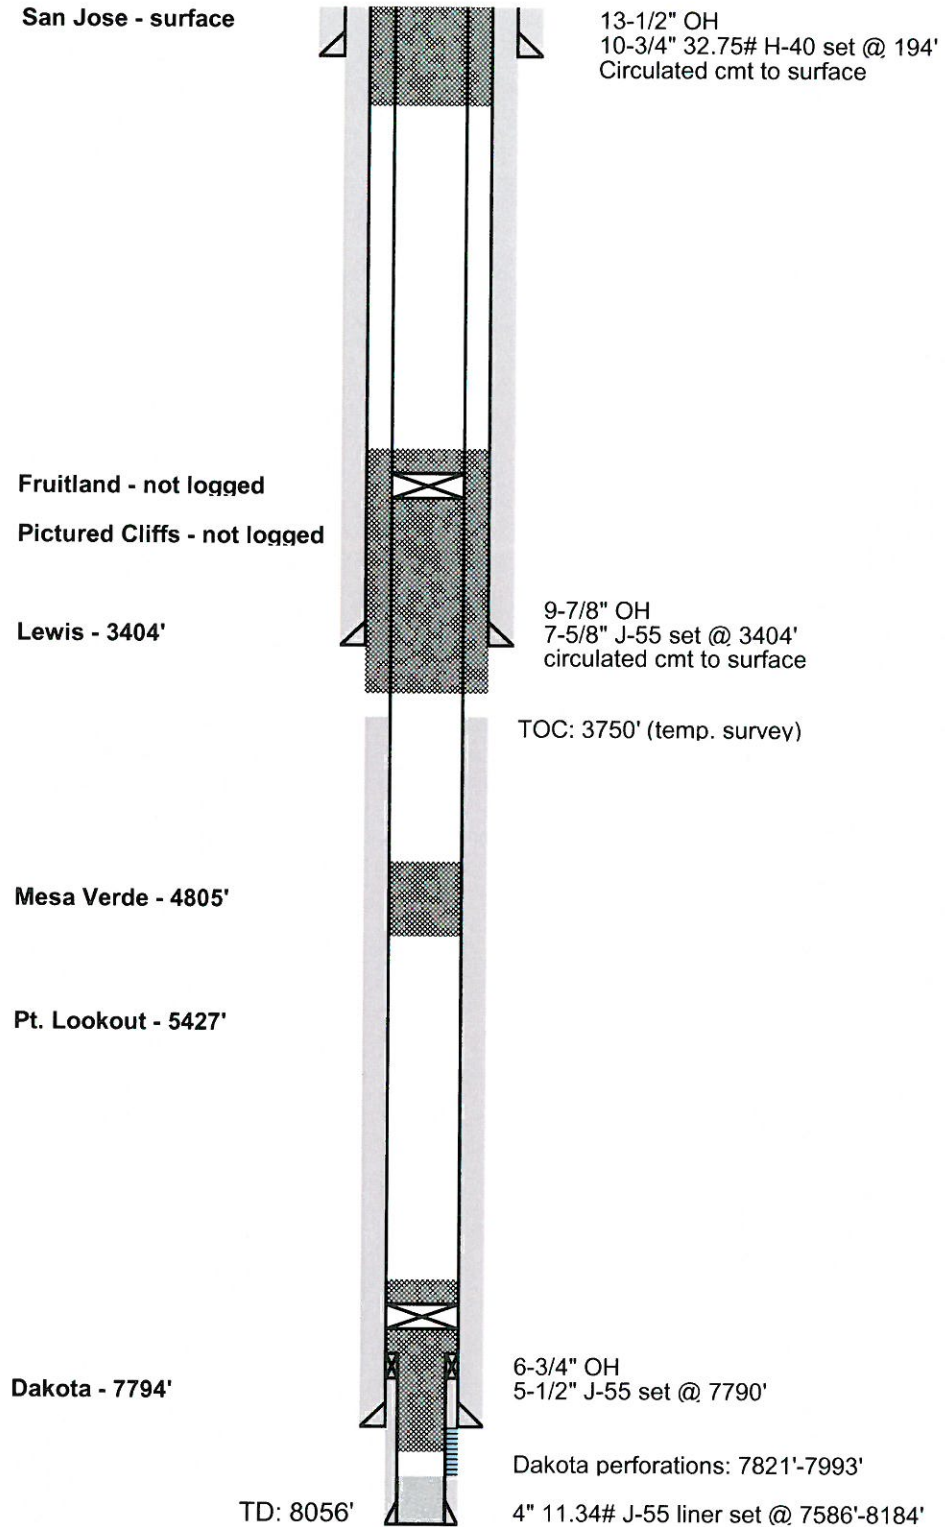

Smith-Ute 1 WBD
2/2/2015