Wellbore DiagramHerrera B1-ANENE Sec. 20, T33N, R8WLa Plata County, COAPI #05-067-08244
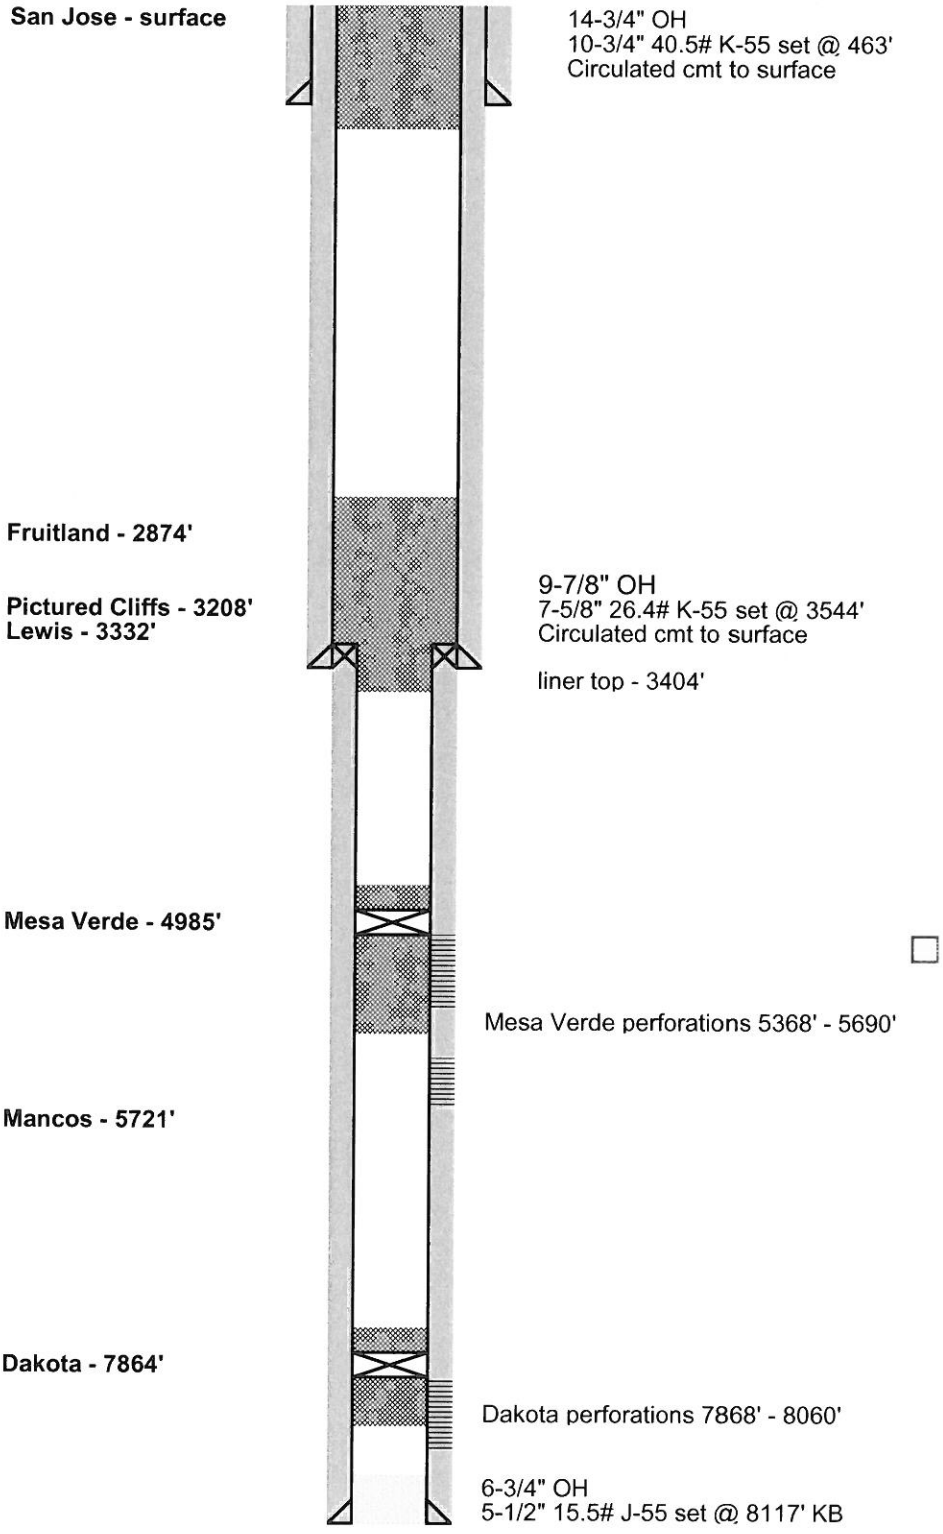
After