Wellbore Diagram
IGE 401
NWNW Sec. 17, T33N, R8W
La Plata County, CO
API #05-067-09023

After

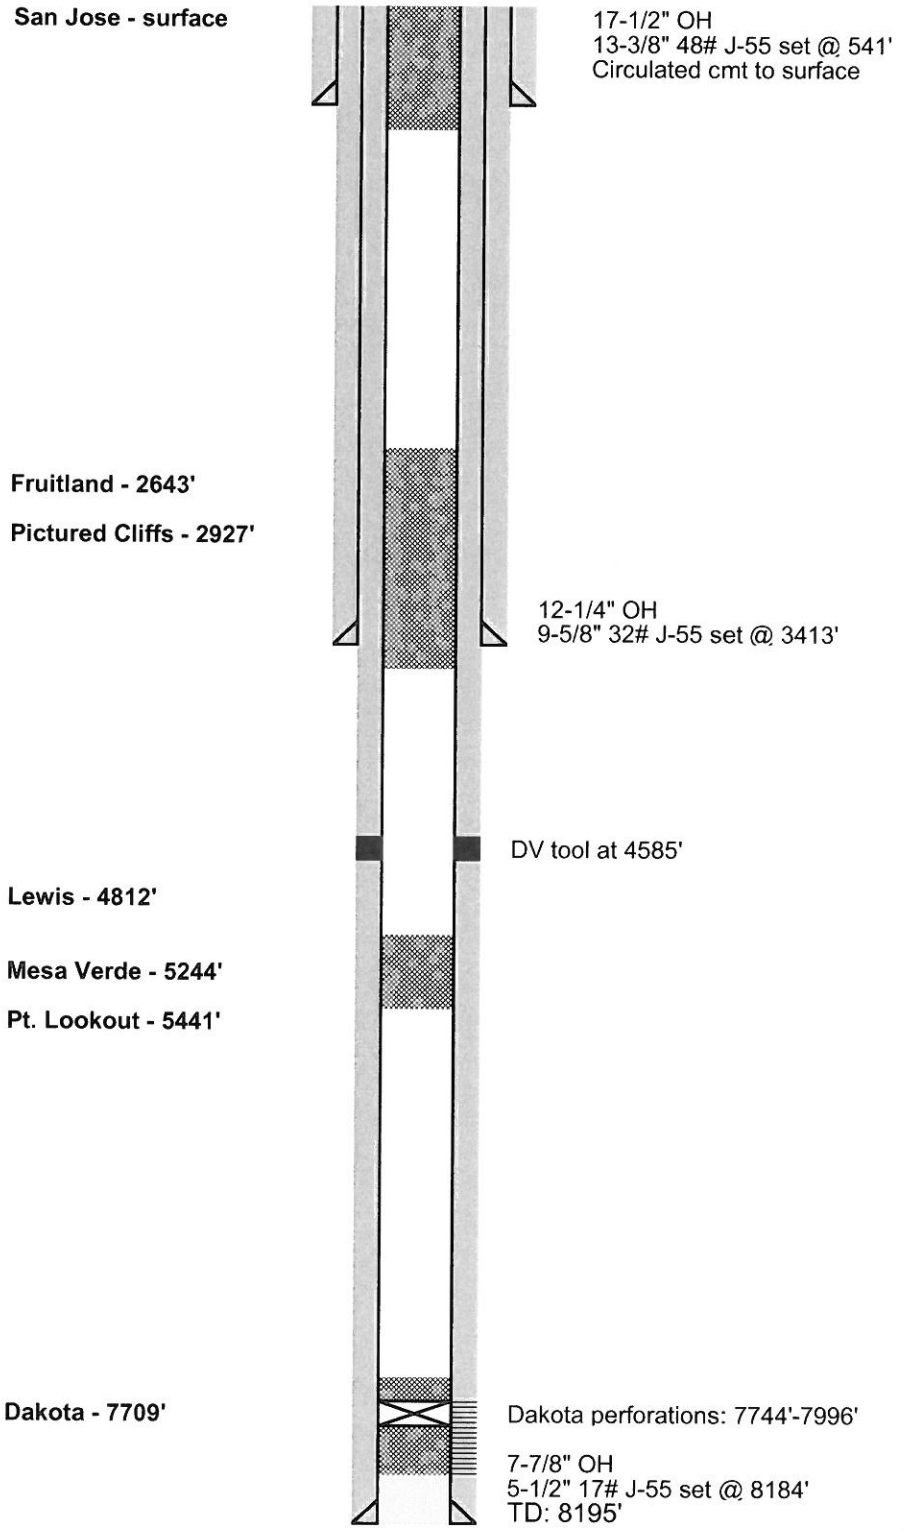

IGE 401 WBD
2/2/2015