



**Weatherford**

INVOICE NUMBER: 11343877 RI SEQ:2  
INVOICE DATE: 10/10/14

CUSTOMER: 1014695  
KINDER MORGAN  
17801 HWY 491  
CORTEZ CO 81321  
UNITED STATES

SHIP TO: 3459920 CW  
WELL: #17  
LEASE: DOE CANYON  
UNITED STATES  
RIG: NABORS M #40

# INVOICE

BILLING PERIOD FROM : OCT 02 2014 TO: OCT 07 2014

BRANCH PLANT: 10198  
WEATHERFORD US LP  
850 S BROWNING PKWY  
FARMINGTON NM 87401  
UNITED STATES

PHONE: 505 327-6341  
FAX: 505 327-7503

# ORIGINAL

DELIVERY TICKET: 10396407 SR  
JOB TYPE: FRE Casing Exits  
SERVICE RATING : STANDARD SERVICE  
JOB NUMBER:  
ORDER DATE: OCT 02 2014  
SHIPPING DATE: OCT 02 2014  
STATE: COLORADO  
COUNTY: DOLORES  
SHIP VIA: DASH

RETURN VIA: WII - WES  
CURRENCY: USD

ORDERED BY: WILLEY HOOPES	ORDER NUMBER: VERBAL	AFE NUMBER:
CONTACT NUMBER: 1-307-880-1171	CONTRACT NUMBER:	PRICE BOOK: 12FISHUS

LINE NO.	DT SEQ DT LINE	QTY UOM	SERIAL NUMBER	DESCRIPTION	ITEM NUMBER/ CONT. REF PRBK REF	SHIP / RETURN	BILL UNITS	PRICE UOM	BILL TYPE	QTY	UNIT BILL	PRICE	GROSS AMOUNT	SURC DISC %	EXTENDED AMOUNT	TAX
AFE: 68744																
1	1	1.00		FISHING TL SUPER LAND-24 HOUR	236580	OCT 02 2014	1.00	EA	Day	4.00	ADD	1,950.00	7,800.00	.00	7,800.00	N
	1.000	EA		JOB RATE	Z00500050155	OCT 06 2014				1.00	NC					
				WES LACKEY												
						BILL FROM: OCT 02 2014 TO: OCT 06 2014										
2	1	1.00	C17260W13578	ASSEM, 7 HW MECH WHIPSTOCK ASS	757364	OCT 02 2014	1.00	EA	Sale	1.00	ADD	73,176.48	73,176.48	.00	51,223.54	Y
	3.000	EA		EM, WITHOUT SHEAR OUT ASSEM										30.00		
3	1	1.00	299668	BEAM, SUPPORT	344490	OCT 02 2014	1.00	EA	Day	1.00	MIN	530.00	530.00	.00	450.50	Y
	10.000	EA			999900000119	OCT 07 2014				5.00	NC			15.00		
						BILL FROM: OCT 02 2014 TO: OCT 07 2014										
4	1	1.00		DP, HW 3-1/2 OD NC38	293706	OCT 02 2014	1.00	EA	Day	1.00	ADD	236.00	236.00	.00	200.60	Y
	13.000	EA			012500100010	OCT 07 2014				5.00	NC			15.00		
						BILL FROM: OCT 02 2014 TO: OCT 07 2014										
5	1	1.00		SHEAR BOLT	126852	OCT 02 2014	1.00	EA	Sale	1.00	ADD	450.00	450.00	.00	450.00	Y
	15.000	EA														
6	1	1.00		TRANSPORTATION WEATHERFORD CA	36793	OCT 02 2014	125.00	EA	Job	1.00	ADD	2.25	281.25	.00	281.25	Y
	17.000	EA		OR PICKUP	Z00500250005	OCT 06 2014										
				WES LACKEY TO AND FROM LOC.												

Freight, Inspections or Repairs, if any, to Follow. Thank you for your business!

INVOICE NUMBER:

11343877 RI

DT NUMBER:10396407 SR

INVOICE

ORIGINAL

LINE NO.	DT SEQ DT LINE	QTY UOM	SERIAL NUMBER	DESCRIPTION	ITEM NUMBER/ CONT. REF PRBK REF	SHIP / RETURN	BILL UNITS	PRICE UOM	BILL TYPE	QTY	UNIT BILL	PRICE	GROSS AMOUNT	SURC DISC %	EXTENDED AMOUNT	TAX
----------	----------------	---------	---------------	-------------	---------------------------------	---------------	------------	-----------	-----------	-----	-----------	-------	--------------	-------------	-----------------	-----

EDl Information  
REQUESTER NAME  
AFE NO./ WBS NO./JOB NO.

CURTIS SLAUGH  
68744

REQUESTER PHONE NUMBER

307-880-1171

TAX SUMMARY

St: CO

2.900

1,525.57

Weatherford (such term shall include any subsidiary, division or affiliate of Weatherford International, Inc.) will provide the requested equipment, materials or services to its customer. Such provision shall be governed by the terms and conditions of the current applicable master service agreement between the parties. In the event that there is no such master service agreement, Weatherford's standard terms and conditions, a copy of which can be found at www.weatherford.com/t&c shall be applicable to the provision of such equipment, materials or services. [A paper copy of these standard terms and conditions will be provided to you upon your written request.]

TERMS:  
REMIT TO:

Net 30 days  
WEATHERFORD U.S., L.P.  
PO BOX 301003  
JP MORGAN CHASE BANK (TX)  
BANK ACCT 0010-318-8448  
ABA ACH 111-000-614 SWIFT:CHASUS33  
DALLAS TX 75303-1003  
UNITED STATES

INVOICE NUMBER:  
DATE:

11343877  
OCT 10 2014

SUBTOTAL : (USD)

60,405.89

TAX : (USD)

1,525.57


TOTAL AMOUNT: (USD)

61,931.46



# Weatherford®

## Casing Exit Technology

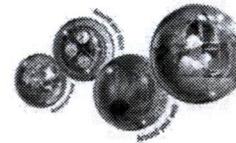

All Around You

Customer: Kinder Morgan  
 Attn: Valerie Cawthorn  
 Well Name: Goodman Point #27  
 Rig:  
 Well #:  
 Location: Montezuma County, CO

Casing Size & Wt: 7 3/4" SD  
 Work String: TBA  
 Drill Collars: TBA  
 H.W.D.P. TBA  
 Job Type: Casing Exit  
 KOP

Type of Whipstock System

Date: 7/2/14

### QC Mechanical Multicatch System



Qty	Item	Min Charge	Add days	Net Amount
2	Whipstock Supervisor Per Day Charge (Est. 2 Days)	\$1,950.00	\$1,950.00	\$3,900.00
1	Whipstock Supervisor Mileage Charge	\$300.00		\$300.00
2	Whipstock Supervisor Subsistence Charge	\$400.00	\$400.00	\$80.00
1	Complete Whipstock System For 7" 3/4" SD	\$73,176.48		\$51,223.54
	System Includes			
1	Concave Type: 5-1/2" OD 3 Deg. Concave			Included
1	Anchor Type: 5-1/4" Multicatch			Included
1	6" Lead Mill			Included
1	6" Flex Mill			Included
	Simulation Run Assembly			
1	6" Window Mill	\$4,920.00		
2	6" Watermelon Mill @ \$4920 ea.	\$9,840.00		
1	Bit Subs 3-1/2" Reg	\$200.00	\$42.00 ✓	
	Additional Equipment			
1	3-1/2" IF HWDP	\$236.00		\$200.60
1	Lift Sub 3-1/2" IF	\$219.00	\$18.00	\$201.45
1	Float Sub W/ 3-1/2" IF	\$200.00	\$80.00	\$238.00
1	Whipstock Support Beam	\$530.00	\$53.00	\$495.55
2	Ditch Magnets	\$1,462.00	\$280.00	\$1,480.70
1	Shear Bolt	\$450.00		\$450.00

Estimated Cost \$ 58,569.84

Cost estimate for budgetary purposes only


- Discounts do not apply to: jars, sub-rented equipment, inspections, transportation, repairs, sales items, supervisor's time, taxes, etc.
- Equipment lost or damaged beyond repair will be sold at current replacement cost.



# Weatherford

## QuickCut™ Bottom Hole Assembly

Customer:		Date:	
Well Name & Number:		Job Number:	
Customer Rep:		Casing Size & Weight:	

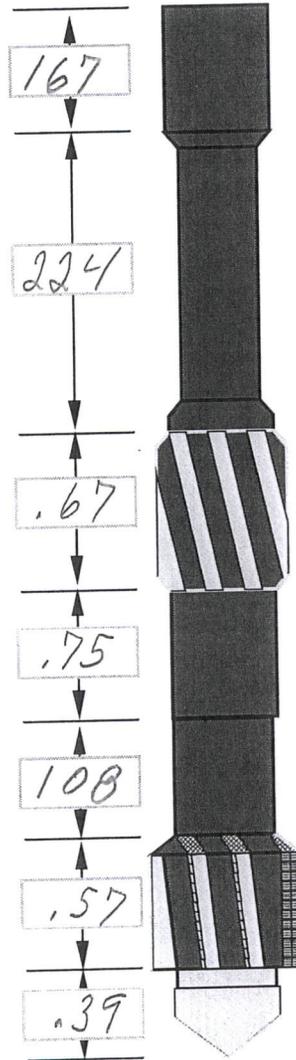

Serial Number: M6556  
 OD: 4 7/8  
 ID: 1 9/16

OD: 3 1/2

OD: 6"

OD: 4 1/4

Serial Number: 2239366  
 OD: 4 3/16  
 ID: 2 1/4

OD: 6"



OD: 4 5/8



# Weatherford

## QuickCut™ Bottom Hole Assembly

Customer:		Date:	
Well Name & Number:		Job Number:	
Customer Rep:		Casing Size & Weight:	

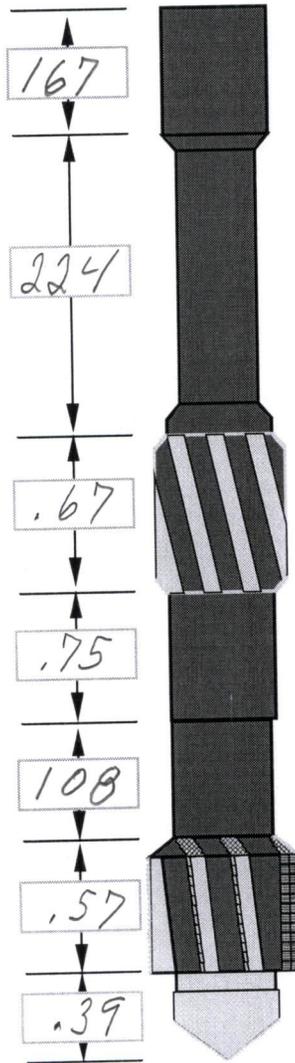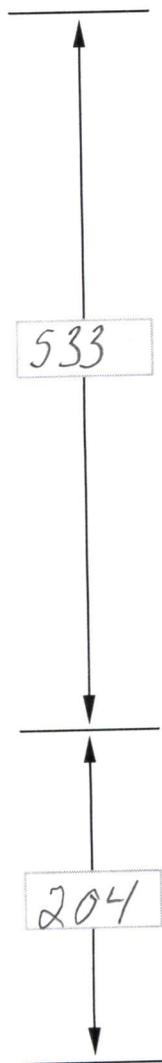

Serial Number: M6556  
 OD: 4 7/8  
 ID: 1 9/16

OD: 3 1/2

OD: 6"

OD: 4 1/4

Serial Number: 2239366  
 OD: 4 3/16  
 ID: 2 1/4

OD: 6"

OD: 4 5/8

Customer  
Kinkize Morgan

Lease & Well#

DT#

Date

OD's

Length's

4 3/4

5 1/2


5 1/2

5 1/4

5 1/2

7" HW  
SN-17260  
C-17260

W-13578

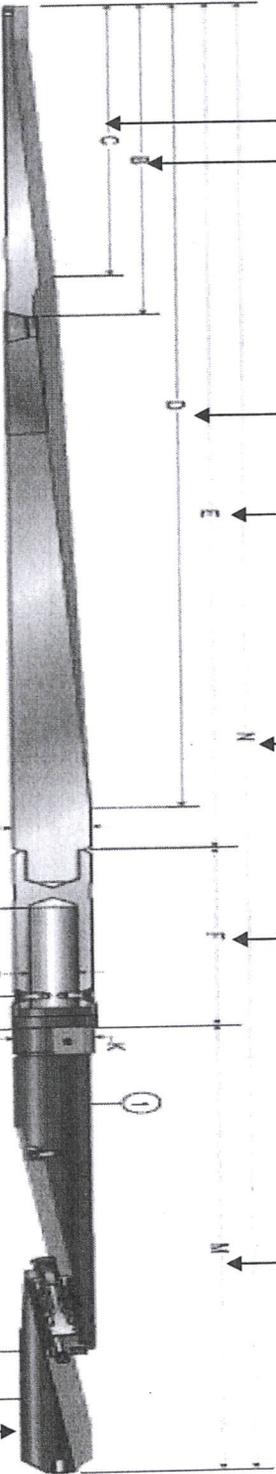

C	3.09
B	3.34
Bottom of Slot	4.74

D	8.96
---	------

E	9.40
---	------

N	13.76
---	-------

F	
J	
H	

M	4.82
---	------

Type of Whipstock

Lug

KOP

Weld

To Top

KOP to Anchor

Customer  

Lease & Well#

DT#

Date

OD's

Length's

4 3/4

5 1/2

5 1/2


5 1/2

5 1/4

5 1/8

7" HW  
C# 17260

W# 13578

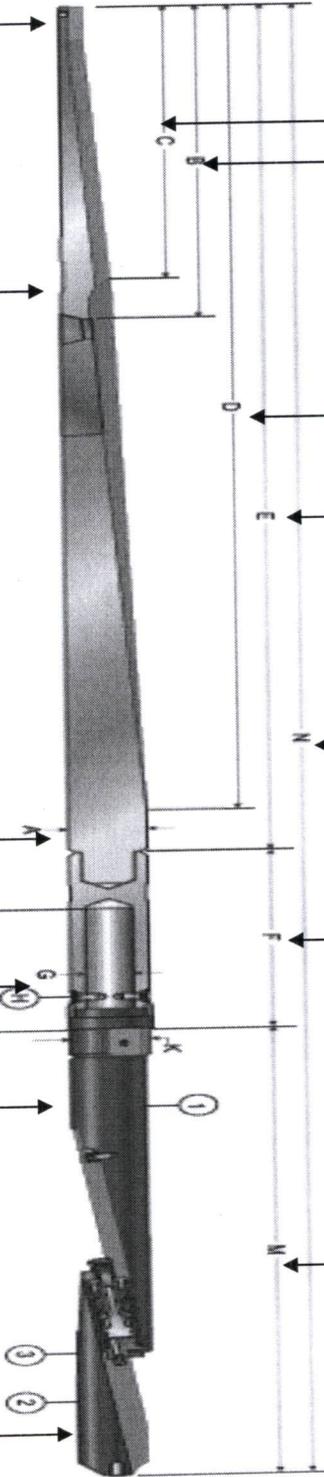

C	3.09
B	3.34

top of slot  
Bottom of Slot

Lug

4.74

D	8.96
---	------

KOP

E	9.40
---	------

Weld

N	13.74
---	-------

To Top

F	
J	
H	

fishing neck  
shear value

M	4.82
---	------

KOP to Anchor

Type of Whipstock



# Weatherford®

## Fishing & Re-Entry Services

**Customer** :           Kinder Morgan          

**Well Name/ Number** :           Doe Canyon # 17          

**Job Start Date** :           Thursday, October 02, 2014          

**AFE #** :           68744          

**D/T #** :           10396407          

**Prepared For** :           Will Hoopes          

**Prepared By** :           Wes Lackey          

Weatherford may give the Company the benefit of its judgement Based on its service to be provide, or the manner of performance or in the prediction of results. Notwithstanding the foregoing, all such recommendations and/or predictions shall be received by the Company as opinions only, and no warranty expressed or implied impracticability of obtaining first-hand knowledge of the many variable conditions, the reliance on inferences, measurements and assumptions which are not infallible, and/or the necessity of relying on facts and supporting oilfield services provided by others.



# Weatherford®

Job End Date : \_\_\_\_\_  
 Field : Doe Canyon  
 State : Colorado  
 County : Dolores  
 Rig Company : Nabors

Well Name & Number : Doe Canyon # 17  
 WFT Location : Farmington  
 D/T Number : 10396407  
 Well Location : East of Dove Creek  
 Rig # : M-40

Well Name DC #17 AFE 68744

Date: 10/5/16 in well view Will Hoopes

Signature: Will Hoopes

Email: CO2 ST\_invoices@kindermorgan.com

Mail To: Kinder Morgan CO2 S&T

1001 Louisiana St., Suite 1000, Houston, TX 77002

Will Hoopes  
 Customer Representative

Signature Will Hoopes  
137-216

Wes Lackey  
 Weatherford Representative

Signature \_\_\_\_\_

Equipment Charges	= \$	51,874.64
Supervisor Charges	= \$	7,800.00
Mileage Charges	= \$	281.25
Inspection Charges	= \$	125.00
Subsistence Charges	= \$	-
<b>Sub Total</b>	<b>= \$</b>	<b>60,080.89</b>

Comments:

**Daily Cost \$**






Company:  
 Company Rep:  
 Field Name:  
 Well Name:

Installation Date:  
 Rig Name:  
 WFT District: Farmington  
 WFT Supervisor: Wes Lackey

### Mechanical QuickCut™ Milling System

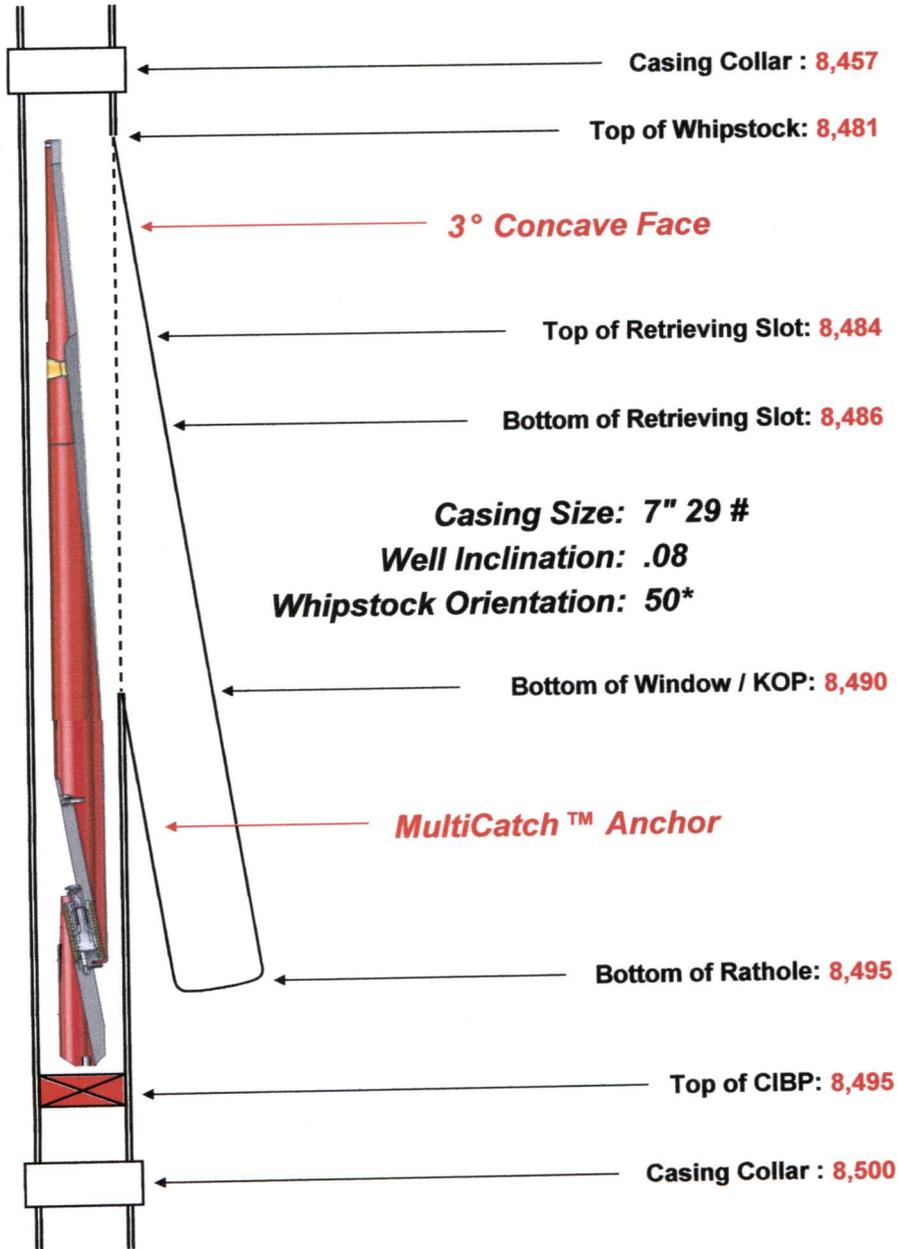

**CAUTION**  
 Be careful when approaching the top of the Whipstock to avoid damaging it. Do not rotate stabilizers, bits, or BHA's through the window to avoid damaging the Whipstock and/or the window. Orient angled Directional Drilling BHA's to the window prior to going through the window to avoid damaging the Whipstock and/or the window.