


KERR-MCGEE OIL AND GAS ONSHORE LP
CANNON LAND 16-3A
SE SE 3 2N 65W -- --
WELD,COLORADO
02/02/2015

AREA: E2 ROUTE: E26 Spud: 01/07/2004 WINS No.: 75305 AFE/WO#: 88628864 API#: 0512321892

GL: 4847 KB: 4857 MTD: 7745 TVD: 7745 LOG MD: 7728 PBMD: 7691 PBTVD: 7691

Directions: WCR 26 AND WCR 43, EAST 1/2 MILE, SOUTH 1/2 MILE, EAST 1/2 MILE, SOUTH INTO LOCATION.

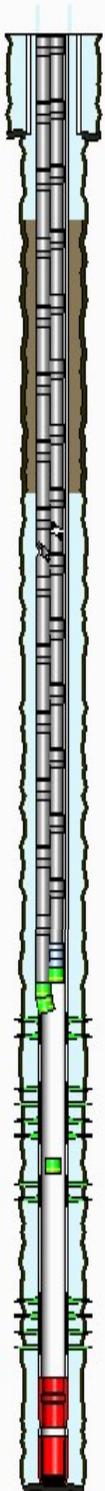

<u>HOLE SECTIONS</u>	<u>Size</u>	<u>Top</u>	<u>Btm</u>	<u>TD Date</u>				
SURFACE	12.25	10	767	01/08/2004				
PRODUCTION	7.88	767	7745	01/14/2004				
<u>TUBULARS</u>	<u>Tool Type</u>	<u>Joints</u>	<u>Size</u>	<u>Weight</u>	<u>Grade</u>	<u>Thread</u>	<u>Top D</u>	<u>Bottom D</u>
SURFACE CASING								
	Casing	17	8.63	24	J-55	STC	10	761
PRODUCTION CASING								
	Casing	183	4.50	11.6	I-80	LTC	10	7691
	Casing Float Collar	1	4.50				7691	7692
	Casing	1	4.50	11.6	I-80	LTC	7692	7718
	Casing Guide Shoe	1	4.50				7718	7719
PRODUCTION TUBING								
	Tubing	220	2.38	4.70	J-55	8RD EUE	10	6828
	Seating Nipple	1	2.38				6828	6829
	Notched Collar	1	2.38				6829	6830
BRIDGE PLUG								
	Cast Iron Bridge Plu	1					7090	7091
PRODUCTION TUBING								
	Tubing	220					10	6862
	XN Profile Nipple	1					6862	6863
	Notched Collar	1					6863	6864
<u>CEMENT JOBS</u>	<u>Stage</u>	<u>Sacks</u>	<u>Cement Jobs</u>			<u>Top D</u>	<u>Btm D</u>	<u>cbl</u>
SURFACE CASING								
	STAGE 1	535		NEAT		10	761	No
PRODUCTION CASING								
	STAGE 1	130		LITE		3450	4740	Yes
	STAGE 1 MIDDLE	90		LITE		4740	6022	Yes
	STAGE 1 TAIL	320		50/50 POZ-MIX		6022	7719	Yes
PRODUCTION CASING								
	ONE INCH JOB	300	LEAD	FRESH WATER		0	1400	No
<u>PERFORATIONS</u>								
<u>Formation</u>	<u>Zone</u>	<u>Top</u>	<u>Btm</u>	<u>Date</u>	<u>Reason</u>	<u>Comments</u>		
NIOBRARA		6865	6877	10/08/2008	PRODUCTION			
NIOBRARA		6866	6876	02/21/2004	PRODUCTION			
NIOBRARA		6956	6960	10/08/2008	PRODUCTION			
NIOBRARA		6973	6977	10/08/2008	PRODUCTION			
CODELL		7110	7125	02/21/2004	PRODUCTION			
J SAND		7567	7582	11/17/2004	PRODUCTION			
J SAND		7590	7605	11/17/2004	PRODUCTION			

Comments: