





Lat40°, Inc. 1635 Foxtrail Drive, Suite 325 Loveland, CO 970-776-3321

# DRILLED & ABANDONED WELL ASBUILT

THIS MAP DOES NOT REPRESENT A BOUNDARY SURVEY

SECTION: 16  
TOWNSHIP: 5N  
RANGE: 61W

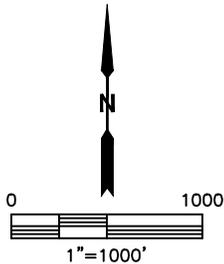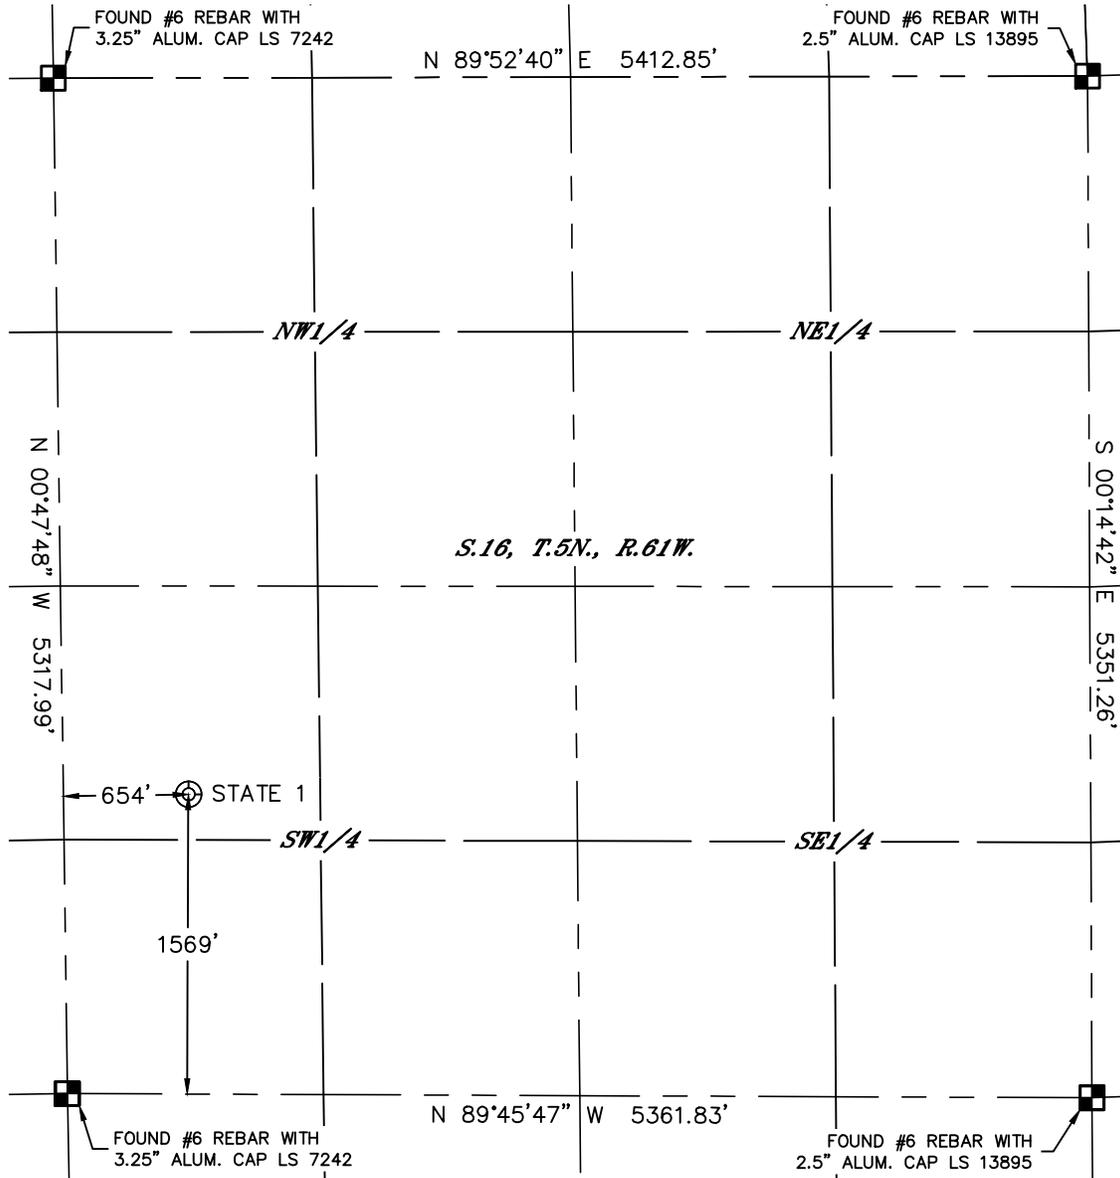

SURFACE LOCATION  
 LAT: 40.39813°N  
 LONG: 104.22132°W  
 PDOP: 1.7  
 ELEV: 4608'  
 1/4,1/4: NWSW

DESCRIPTION  
 FOUND 8" DIAMETER CAPPED STEEL PIPE APPROXIMATELY  
 4.5' BELOW GRADE.

LEGEND

- = ALIQUOT MONUMENT AS DESCRIBED
- = CALCULATED POSITION

DATE: 6/27/2014  
PROJECT#: 2013173



Lat40°, Inc. 1635 Foxtrail Drive, Suite 325 Loveland, CO 970-776-3321

# D&A WELL LOCATION PICTURES

STATE 1

SECTION: 16  
TOWNSHIP: 5N  
RANGE: 61W

DATE: 6/25/2014



VIEW NORTH



VIEW EAST



VIEW WEST



VIEW SOUTH



MARKER VIEW

DATE: 6/27/2014  
PROJECT#: 2013173