



Noble Energy Inc.

**Weld County, CO
Sec 28, T9N, R59W, 6th PM
Cutthroat LC28-72HNB**

Wellbore #1

Design: Wellbore #1 FINAL

DDC Survey Report

25 July, 2014



Company:	Noble Energy Inc.	Local Co-ordinate Reference:	Well Cutthroat LC28-72HNB
Project:	Weld County, CO	TVD Reference:	WELL @ 4867.0usft (H&P #326)
Site:	Sec 28, T9N, R59W, 6th PM	MD Reference:	WELL @ 4867.0usft (H&P #326)
Well:	Cutthroat LC28-72HNB	North Reference:	Grid
Wellbore:	Wellbore #1	Survey Calculation Method:	Minimum Curvature
Design:	Wellbore #1	Database:	EDM Compass

Project	Weld County, CO		
Map System:	US State Plane 1983	System Datum:	Mean Sea Level
Geo Datum:	North American Datum 1983		
Map Zone:	Colorado Northern Zone		

Site		Sec 28, T9N, R59W, 6th PM			
Site Position:		Northing:	1,506,743.69 usft	Latitude:	40° 42' 52.295 N
From:	Map	Easting:	3,420,557.77 usft	Longitude:	103° 58' 58.302 W
Position Uncertainty:	0.0 usft	Slot Radius:	13-3/16 "	Grid Convergence:	0.98 °

Well		Cutthroat LC28-72HNB				
Well Position	+N/-S	0.0 usft	Northing:	1,506,956.37 usft	Latitude:	40° 42' 54.108 N
	+E/-W	0.0 usft	Easting:	3,422,262.50 usft	Longitude:	103° 58' 36.120 W
Position Uncertainty		0.0 usft	Wellhead Elevation:	0.0 usft	Ground Level:	4,837.0 usft

Wellbore	Wellbore #1				
Magnetics	Model Name	Sample Date	Declination (°)	Dip Angle (°)	Field Strength (nT)
	IGRF2010	7/18/2014	8.04	67.32	53,049

Design	Wellbore #1				
Audit Notes:					
Version:	1.0	Phase:	ACTUAL	Tie On Depth:	0.0
Vertical Section:	Depth From (TVD) (usft)	+N/-S (usft)	+E/-W (usft)	Direction (°)	
	0.0	0.0	0.0	2.08	

Survey Program	Date	7/25/2014			
From (usft)	To (usft)	Survey (Wellbore)	Tool Name	Description	
286.0	633.0	Surface Surveys (Wellbore #1)	Flexi-Shot	VES Flexi-Shot Tool	
648.0	6,415.0	MWD Surveys - Vert/Build (Wellbore #1)	MWD default	MWD - Standard	
6,478.0	10,406.0	MWD Surveys - Lateral (Wellbore #1)	MWD default	MWD - Standard	

Survey										
Measured Depth (usft)	Inclination (°)	Azimuth (°)	Vertical Depth (usft)	+N/-S (usft)	+E/-W (usft)	Vertical Section (usft)	Dogleg Rate (°/100usft)	Build Rate (°/100usft)	Turn Rate (°/100usft)	
0.0	0.00	0.00	0.0	0.0	0.0	0.0	0.00	0.00	0.00	
286.0	0.20	3.85	286.0	0.5	0.0	0.5	0.07	0.07	0.00	
TIE IN @ 633' MD / 633' TVD / END OF SUR HOLE / BEGIN INT HOLE										
633.0	0.50	108.45	633.0	0.6	1.5	0.7	0.17	0.09	30.14	
648.0	0.53	106.38	648.0	0.6	1.6	0.6	0.24	0.20	-13.81	
741.0	0.70	103.92	741.0	0.3	2.6	0.4	0.18	0.18	-2.65	
833.0	0.62	91.96	833.0	0.2	3.6	0.3	0.17	-0.09	-13.00	
925.0	0.53	101.10	925.0	0.1	4.6	0.2	0.14	-0.10	9.93	
1,019.0	0.53	97.76	1,019.0	-0.1	5.4	0.1	0.03	0.00	-3.55	

Company:	Noble Energy Inc.	Local Co-ordinate Reference:	Well Cutthroat LC28-72HNB
Project:	Weld County, CO	TVD Reference:	WELL @ 4867.0usft (H&P #326)
Site:	Sec 28, T9N, R59W, 6th PM	MD Reference:	WELL @ 4867.0usft (H&P #326)
Well:	Cutthroat LC28-72HNB	North Reference:	Grid
Wellbore:	Wellbore #1	Survey Calculation Method:	Minimum Curvature
Design:	Wellbore #1	Database:	EDM Compass

Survey									
Measured Depth (usft)	Inclination (°)	Azimuth (°)	Vertical Depth (usft)	+N/-S (usft)	+E/-W (usft)	Vertical Section (usft)	Dogleg Rate (°/100usft)	Build Rate (°/100usft)	Turn Rate (°/100usft)
1,111.0	0.44	104.97	1,111.0	-0.2	6.2	0.0	0.12	-0.10	7.84
1,204.0	0.70	120.97	1,204.0	-0.6	7.0	-0.3	0.33	0.28	17.20
1,295.0	0.97	141.71	1,295.0	-1.5	8.0	-1.2	0.44	0.30	22.79
1,387.0	1.06	137.67	1,386.9	-2.7	9.0	-2.4	0.12	0.10	-4.39
1,480.0	1.23	134.68	1,479.9	-4.1	10.3	-3.7	0.19	0.18	-3.22
1,572.0	3.08	146.45	1,571.9	-6.8	12.4	-6.4	2.06	2.01	12.79
1,664.0	5.10	140.65	1,663.6	-12.0	16.3	-11.4	2.24	2.20	-6.30
1,758.0	6.51	130.63	1,757.1	-18.7	23.0	-17.9	1.84	1.50	-10.66
1,850.0	8.97	132.39	1,848.3	-27.0	32.3	-25.8	2.69	2.67	1.91
1,943.0	11.17	132.92	1,939.9	-38.0	44.2	-36.4	2.37	2.37	0.57
2,036.0	12.13	136.96	2,030.9	-51.3	57.5	-49.2	1.35	1.03	4.34
2,129.0	12.49	139.42	2,121.8	-66.1	70.7	-63.5	0.68	0.39	2.65
2,223.0	13.72	142.94	2,213.3	-82.7	84.1	-79.6	1.56	1.31	3.74
2,317.0	12.57	140.30	2,304.9	-99.4	97.3	-95.8	1.38	-1.22	-2.81
2,412.0	11.70	139.95	2,397.8	-114.8	110.1	-110.7	0.92	-0.92	-0.37
2,506.0	10.55	137.84	2,490.0	-128.4	122.0	-123.9	1.30	-1.22	-2.24
2,600.0	10.73	136.96	2,582.4	-141.2	133.8	-136.3	0.26	0.19	-0.94
2,695.0	11.26	137.84	2,675.6	-154.6	146.0	-149.2	0.59	0.56	0.93
2,790.0	11.43	137.14	2,768.8	-168.3	158.7	-162.5	0.23	0.18	-0.74
2,884.0	11.61	135.56	2,860.9	-181.9	171.6	-175.6	0.39	0.19	-1.68
2,979.0	11.08	133.62	2,954.0	-195.0	184.9	-188.2	0.69	-0.56	-2.04
3,073.0	10.02	131.16	3,046.4	-206.7	197.6	-199.3	1.22	-1.13	-2.62
3,168.0	7.74	142.41	3,140.3	-217.2	207.7	-209.5	3.01	-2.40	11.84
3,262.0	6.68	140.30	3,233.6	-226.4	215.1	-218.4	1.16	-1.13	-2.24
3,356.0	7.30	139.60	3,326.9	-235.1	222.5	-226.9	0.67	0.66	-0.74
3,451.0	8.27	139.07	3,421.0	-244.9	230.8	-236.4	1.02	1.02	-0.56
3,545.0	7.56	141.53	3,514.1	-254.8	239.1	-246.0	0.84	-0.76	2.62
3,640.0	6.95	144.87	3,608.3	-264.4	246.3	-255.3	0.78	-0.64	3.52
3,735.0	5.36	132.39	3,702.8	-272.1	252.9	-262.8	2.18	-1.67	-13.14
3,829.0	2.90	136.08	3,796.5	-276.8	257.8	-267.3	2.63	-2.62	3.93
3,924.0	2.81	137.49	3,891.4	-280.3	261.0	-270.6	0.12	-0.09	1.48
4,018.0	2.99	112.53	3,985.3	-282.9	264.8	-273.1	1.35	0.19	-26.55
4,113.0	2.37	119.21	4,080.2	-284.8	268.9	-274.9	0.73	-0.65	7.03
4,207.0	2.46	182.67	4,174.1	-287.8	270.5	-277.8	2.70	0.10	67.51
4,302.0	0.97	269.68	4,269.1	-289.8	269.6	-279.8	2.73	-1.57	91.59
4,396.0	0.88	314.15	4,363.1	-289.3	268.2	-279.4	0.75	-0.10	47.31
4,491.0	0.88	309.05	4,458.1	-288.3	267.2	-278.5	0.08	0.00	-5.37
4,585.0	0.62	179.15	4,552.1	-288.4	266.6	-278.5	1.45	-0.28	-138.19
4,680.0	0.35	83.17	4,647.1	-288.9	266.9	-279.0	0.78	-0.28	-101.03
4,775.0	1.14	39.40	4,742.0	-288.1	267.8	-278.2	0.97	0.83	-46.07
4,870.0	1.14	161.92	4,837.0	-288.3	268.7	-278.3	2.10	0.00	128.97
4,964.0	1.23	167.02	4,931.0	-290.1	269.2	-280.2	0.15	0.10	5.43
5,058.0	0.88	182.14	5,025.0	-291.9	269.4	-281.9	0.47	-0.37	16.09

Company:	Noble Energy Inc.	Local Co-ordinate Reference:	Well Cutthroat LC28-72HNB
Project:	Weld County, CO	TVD Reference:	WELL @ 4867.0usft (H&P #326)
Site:	Sec 28, T9N, R59W, 6th PM	MD Reference:	WELL @ 4867.0usft (H&P #326)
Well:	Cutthroat LC28-72HNB	North Reference:	Grid
Wellbore:	Wellbore #1	Survey Calculation Method:	Minimum Curvature
Design:	Wellbore #1	Database:	EDM Compass

Survey									
Measured Depth (usft)	Inclination (°)	Azimuth (°)	Vertical Depth (usft)	+N/-S (usft)	+E/-W (usft)	Vertical Section (usft)	Dogleg Rate (°/100usft)	Build Rate (°/100usft)	Turn Rate (°/100usft)
5,153.0	0.53	190.58	5,120.0	-293.0	269.3	-283.0	0.38	-0.37	8.88
5,247.0	0.44	186.53	5,214.0	-293.8	269.2	-283.8	0.10	-0.10	-4.31
5,303.0	0.62	219.76	5,270.0	-294.2	268.9	-284.3	0.62	0.32	59.34
5,341.0	0.79	217.47	5,308.0	-294.6	268.7	-284.7	0.45	0.45	-6.03
5,436.0	6.77	9.17	5,402.8	-289.6	269.1	-279.6	7.87	6.29	159.68
5,531.0	18.82	4.07	5,495.3	-268.7	271.1	-258.7	12.73	12.68	-5.37
5,626.0	25.50	6.71	5,583.2	-233.1	274.6	-223.0	7.11	7.03	2.78
5,720.0	32.62	2.31	5,665.3	-187.6	278.0	-177.4	7.90	7.57	-4.68
5,814.0	40.45	359.33	5,740.8	-131.7	278.7	-121.5	8.54	8.33	-3.17
5,909.0	47.75	1.08	5,809.0	-65.6	279.0	-55.5	7.79	7.68	1.84
6,003.0	52.94	0.38	5,868.9	6.7	279.9	16.9	5.55	5.52	-0.74
6,098.0	51.44	359.15	5,927.2	81.7	279.6	91.8	1.88	-1.58	-1.29
6,193.0	61.38	355.99	5,979.7	160.7	276.1	170.6	10.82	10.46	-3.33
6,287.0	75.27	356.34	6,014.3	247.6	270.3	257.3	14.78	14.78	0.37
CROSSED 600' HARD LINE @ 6306' MD / 6019' TVD									
6,306.3	76.59	356.30	6,019.0	266.3	269.1	275.9	6.86	6.85	-0.19
6,382.0	81.78	356.16	6,033.2	340.5	264.2	349.9	6.86	6.85	-0.19
6,415.0	81.69	355.81	6,037.9	373.1	261.9	382.3	1.08	-0.27	-1.06
7" CASING POINT @ 6462' MD / 6044' TVD / END OF INT HOLE / BEGIN LATERAL									
6,462.0	83.92	356.33	6,043.8	419.6	258.7	428.7	4.87	4.75	1.10
6,478.0	84.68	356.50	6,045.4	435.5	257.7	444.5	4.87	4.75	1.09
6,539.0	85.91	357.21	6,050.4	496.2	254.4	505.1	2.33	2.02	1.16
6,632.0	88.55	357.03	6,054.9	588.9	249.7	597.6	2.85	2.84	-0.19
6,724.0	88.37	356.33	6,057.4	680.8	244.4	689.2	0.79	-0.20	-0.76
6,818.0	88.46	355.10	6,060.0	774.5	237.4	782.6	1.31	0.10	-1.31
6,912.0	87.23	358.96	6,063.5	868.2	232.5	876.1	4.31	-1.31	4.11
7,006.0	90.04	1.07	6,065.8	962.2	232.5	970.0	3.74	2.99	2.24
7,101.0	90.40	1.07	6,065.4	1,057.2	234.3	1,065.0	0.38	0.38	0.00
7,196.0	90.31	0.02	6,064.8	1,152.2	235.2	1,160.0	1.11	-0.09	-1.11
7,290.0	89.96	358.61	6,064.6	1,246.2	234.1	1,253.8	1.55	-0.37	-1.50
7,384.0	90.04	357.03	6,064.6	1,340.1	230.5	1,347.6	1.68	0.09	-1.68
7,479.0	90.37	358.96	6,064.3	1,435.0	227.2	1,442.3	2.06	0.35	2.03
7,573.0	90.40	358.79	6,063.6	1,529.0	225.3	1,536.2	0.18	0.03	-0.18
7,668.0	90.48	358.96	6,062.9	1,624.0	223.5	1,631.0	0.20	0.08	0.18
7,763.0	89.60	358.09	6,062.8	1,719.0	221.0	1,725.8	1.30	-0.93	-0.92
7,857.0	90.75	357.91	6,062.5	1,812.9	217.8	1,819.6	1.24	1.22	-0.19
7,951.0	88.64	356.85	6,063.0	1,906.8	213.5	1,913.3	2.51	-2.24	-1.13
8,046.0	88.72	1.07	6,065.2	2,001.7	211.7	2,008.1	4.44	0.08	4.44
8,140.0	87.49	0.19	6,068.3	2,095.7	212.8	2,102.0	1.61	-1.31	-0.94
8,235.0	90.31	359.67	6,070.2	2,190.6	212.6	2,196.9	3.02	2.97	-0.55
8,329.0	89.34	358.79	6,070.4	2,284.6	211.4	2,290.8	1.39	-1.03	-0.94
8,424.0	92.07	359.14	6,069.3	2,379.6	209.7	2,385.6	2.90	2.87	0.37
8,518.0	92.24	357.91	6,065.7	2,473.5	207.3	2,479.4	1.32	0.18	-1.31
8,613.0	91.36	356.50	6,062.8	2,568.3	202.6	2,574.0	1.75	-0.93	-1.48

Company:	Noble Energy Inc.	Local Co-ordinate Reference:	Well Cutthroat LC28-72HNB
Project:	Weld County, CO	TVD Reference:	WELL @ 4867.0usft (H&P #326)
Site:	Sec 28, T9N, R59W, 6th PM	MD Reference:	WELL @ 4867.0usft (H&P #326)
Well:	Cutthroat LC28-72HNB	North Reference:	Grid
Wellbore:	Wellbore #1	Survey Calculation Method:	Minimum Curvature
Design:	Wellbore #1	Database:	EDM Compass

Survey										
Measured Depth (usft)	Inclination (°)	Azimuth (°)	Vertical Depth (usft)	+N/-S (usft)	+E/-W (usft)	Vertical Section (usft)	Dogleg Rate (°/100usft)	Build Rate (°/100usft)	Turn Rate (°/100usft)	
8,707.0	90.92	353.69	6,060.9	2,662.0	194.6	2,667.3	3.03	-0.47	-2.99	
8,802.0	90.31	357.56	6,059.9	2,756.7	187.3	2,761.6	4.12	-0.64	4.07	
8,896.0	90.31	359.84	6,059.4	2,850.6	185.2	2,855.5	2.43	0.00	2.43	
8,991.0	91.36	0.55	6,058.0	2,945.6	185.5	2,950.4	1.33	1.11	0.75	
9,086.0	90.04	0.19	6,056.8	3,040.6	186.1	3,045.4	1.44	-1.39	-0.38	
9,180.0	88.55	1.42	6,058.0	3,134.6	187.5	3,139.3	2.06	-1.59	1.31	
9,275.0	87.85	0.72	6,061.0	3,229.5	189.2	3,234.3	1.04	-0.74	-0.74	
9,369.0	87.41	0.55	6,064.8	3,323.4	190.3	3,328.2	0.50	-0.47	-0.18	
9,464.0	89.69	0.37	6,067.2	3,418.4	191.0	3,423.1	2.41	2.40	-0.19	
9,558.0	89.69	0.55	6,067.8	3,512.4	191.8	3,517.0	0.19	0.00	0.19	
9,652.0	89.43	359.84	6,068.5	3,606.4	192.1	3,611.0	0.80	-0.28	-0.76	
9,747.0	88.29	357.73	6,070.4	3,701.3	190.1	3,705.8	2.52	-1.20	-2.22	
9,841.0	91.45	357.21	6,070.6	3,795.2	186.0	3,799.5	3.41	3.36	-0.55	
9,936.0	91.80	358.44	6,067.9	3,890.1	182.4	3,894.2	1.35	0.37	1.29	
10,030.0	92.15	357.03	6,064.6	3,984.0	178.6	3,987.9	1.54	0.37	-1.50	
10,125.0	89.52	355.98	6,063.3	4,078.8	172.8	4,082.4	2.98	-2.77	-1.11	
10,219.0	87.85	354.22	6,065.4	4,172.4	164.8	4,175.7	2.58	-1.78	-1.87	
10,314.0	88.55	352.28	6,068.4	4,266.7	153.7	4,269.5	2.17	0.74	-2.04	
10,355.0	87.93	351.23	6,069.7	4,307.3	147.8	4,309.8	2.97	-1.51	-2.56	
TD @ 10406' MD / 6072' TVD										
10,406.0	87.93	351.23	6,071.5	4,357.6	140.0	4,359.9	0.00	0.00	0.00	

Design Annotations					
Measured Depth (usft)	Vertical Depth (usft)	Local Coordinates			
		+N/-S (usft)	+E/-W (usft)	Comment	
633.0	633.0	0.6	1.5	TIE IN @ 633' MD / 633' TVD / END OF SUR HOLE / BEGIN INT HOLE	
6,306.3	6,019.0	266.3	269.1	CROSSED 600' HARD LINE @ 6306' MD / 6019' TVD	
6,462.0	6,043.8	419.6	258.7	7" CASING POINT @ 6462' MD / 6044' TVD / END OF INT HOLE / BEGIN LAT	
10,406.0	6,071.5	4,357.6	140.0	TD @ 10406' MD / 6072' TVD	

Checked By: _____ Approved By: _____ Date: _____



Survey Certification Sheet

Noble Energy Inc.
Company

RM-140691
Job Number

8/05/14
Date

Sec 28,T9N,R59W,6th PM
Lease

Cutthroat LC28-72HNB
Well Name

Weld, CO
County & State

API: 05-123-38603

Surveyed from a depth of: 633 feet to 10406 feet MD

Type of Survey: MWD

Directional Supervisor/Surveyor: Bob Kubistek

The data and calculations for this survey have been checked by me and conform to the standards and procedures set forth by **The Directional Drilling Company (DDC)**. This report represents a true and correct Directional survey of this well based on the original data obtained at the well site. Wellbore Coordinates are calculated using minimum curvature.

Digitally signed by Larry Wright
DN: cn=Larry Wright, o=The
Directional Drilling Company,
ou=GM of Guidance Services,
email=larryw@directionaldrillers.c
om, c=US
Date: 2014.08.05 15:21:45 -05'00'

Larry Wright
MWD General Manager

Company Name: Noble Energy Inc.
Cutthroat LC28-72HNB
Weld County, CO
Rig: H&P #326
Created By: Kris Ray
Date: 7/25/2014

Cutthroat LC28-72HNB
Weld County, CO
Q140669 & RM-140691
Design #1



T


G

M

Azimuths to Grid North

Correction: 7.05°
Magnetic Field

Strength: 53049.1snT
Dip Angle: 67.32°
Date: 7/18/2014
Model: IGRF2010


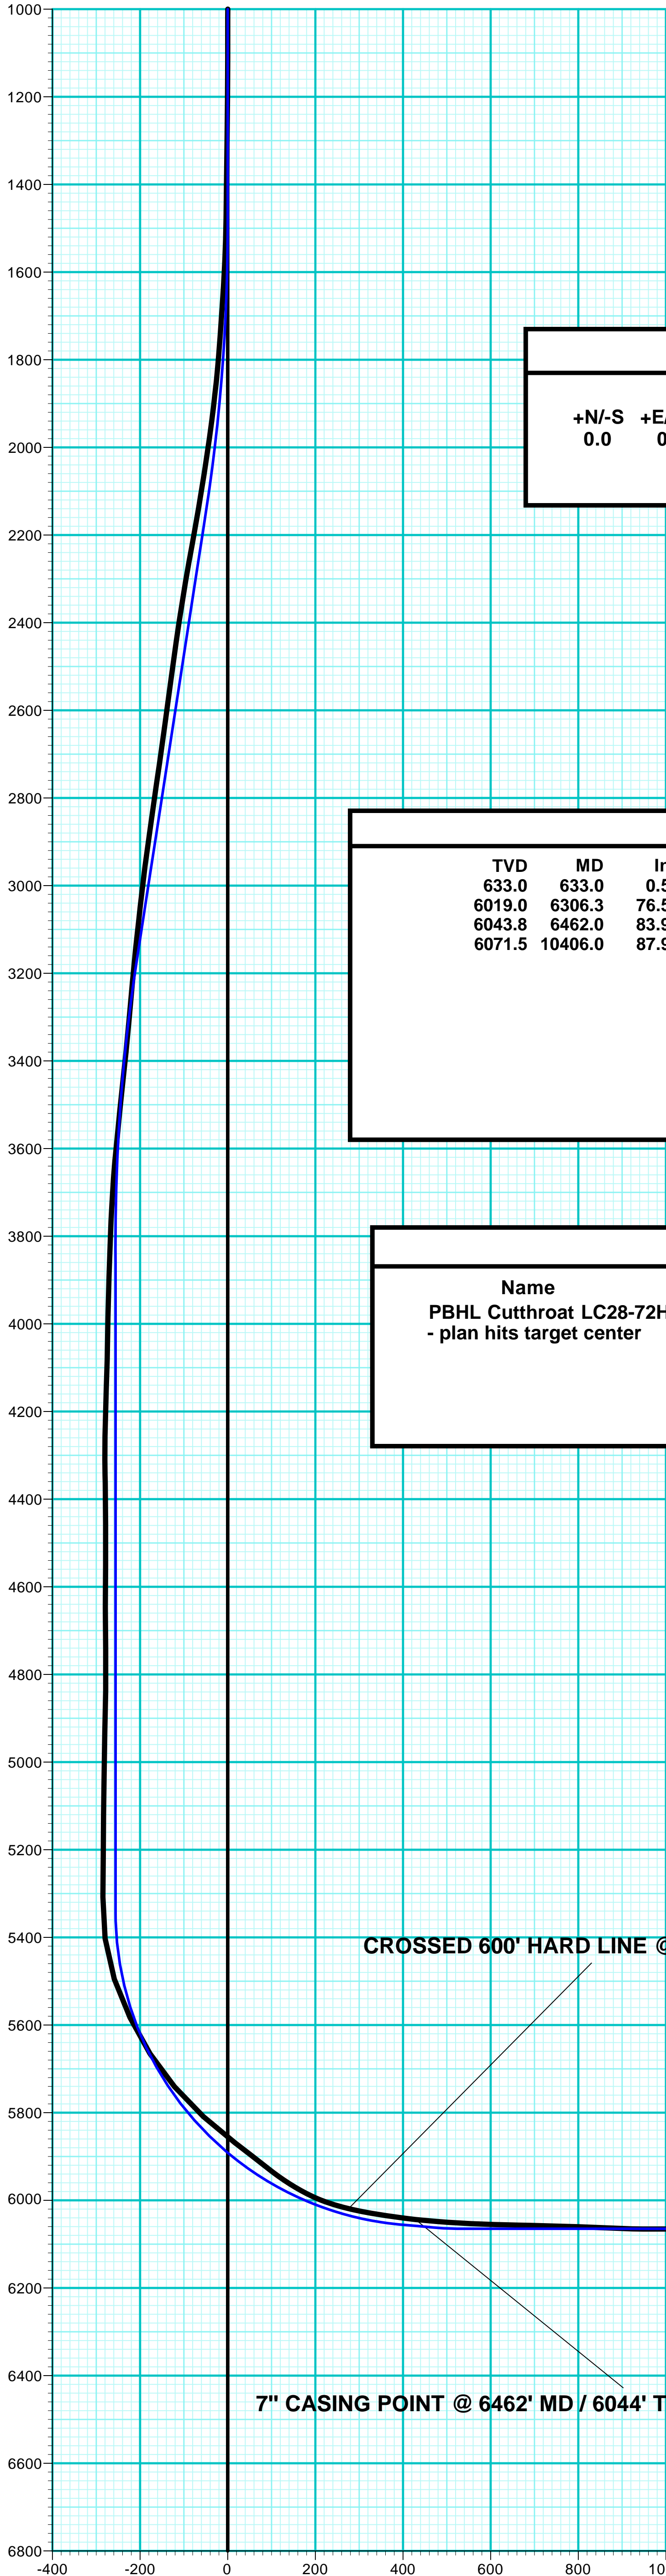


PROJECT DETAILS:		Weld County, CO	
Geodetic System:	US State Plane 1983		
Datum:	North American Datum 1983		
Ellipsoid:	GRS 1980		
Zone:	Colorado Northern Zone		
System Datum:	Mean Sea Level		

WELL DETAILS:		Cutthroat LC28-72HNB	
Ground Level:		4837.0	
+N/-S	+E/-W	Northing	Easting
0.0	0.0	1506956.37	3422262.50
		Latitude	Longitude
		40° 42' 54.108 N	103° 58' 36.120 W
		Slot	

ANNOTATIONS									
TVD	MD	Inc	Azi	+N/-S	+E/-W	VSect	Departure	Annotation	
633.0	633.0	0.50	108.45	0.6	1.5	0.7	2.6	TIE IN @ 633' MD / 633' TVD / END OF SUR HOLE / BEGIN INT HOLE	
6019.0	6306.3	76.59	356.30	266.3	269.1	275.9	980.9	CROSSED 600' HARD LINE @ 6306' MD / 6019' TVD	
6043.8	6462.0	83.92	356.33	419.6	258.7	428.7	1134.3	7" CASING POINT @ 6462' MD / 6044' TVD / END OF INT HOLE / BEGIN LATERAL	
6071.5	10406.0	87.93	351.23	4357.6	140.0	4359.9	5077.0	TD @ 10406' MD / 6072' TVD	

DESIGN TARGET DETAILS						
Name	TVD	+N/-S	+E/-W	Northing	Easting	Latitude
PBHL Cutthroat LC28-72HNB	6065.0	4357.1	158.0	1511313.46	3422420.50	40° 43' 37.128 N
- plan hits target center						103° 58' 33.096 W

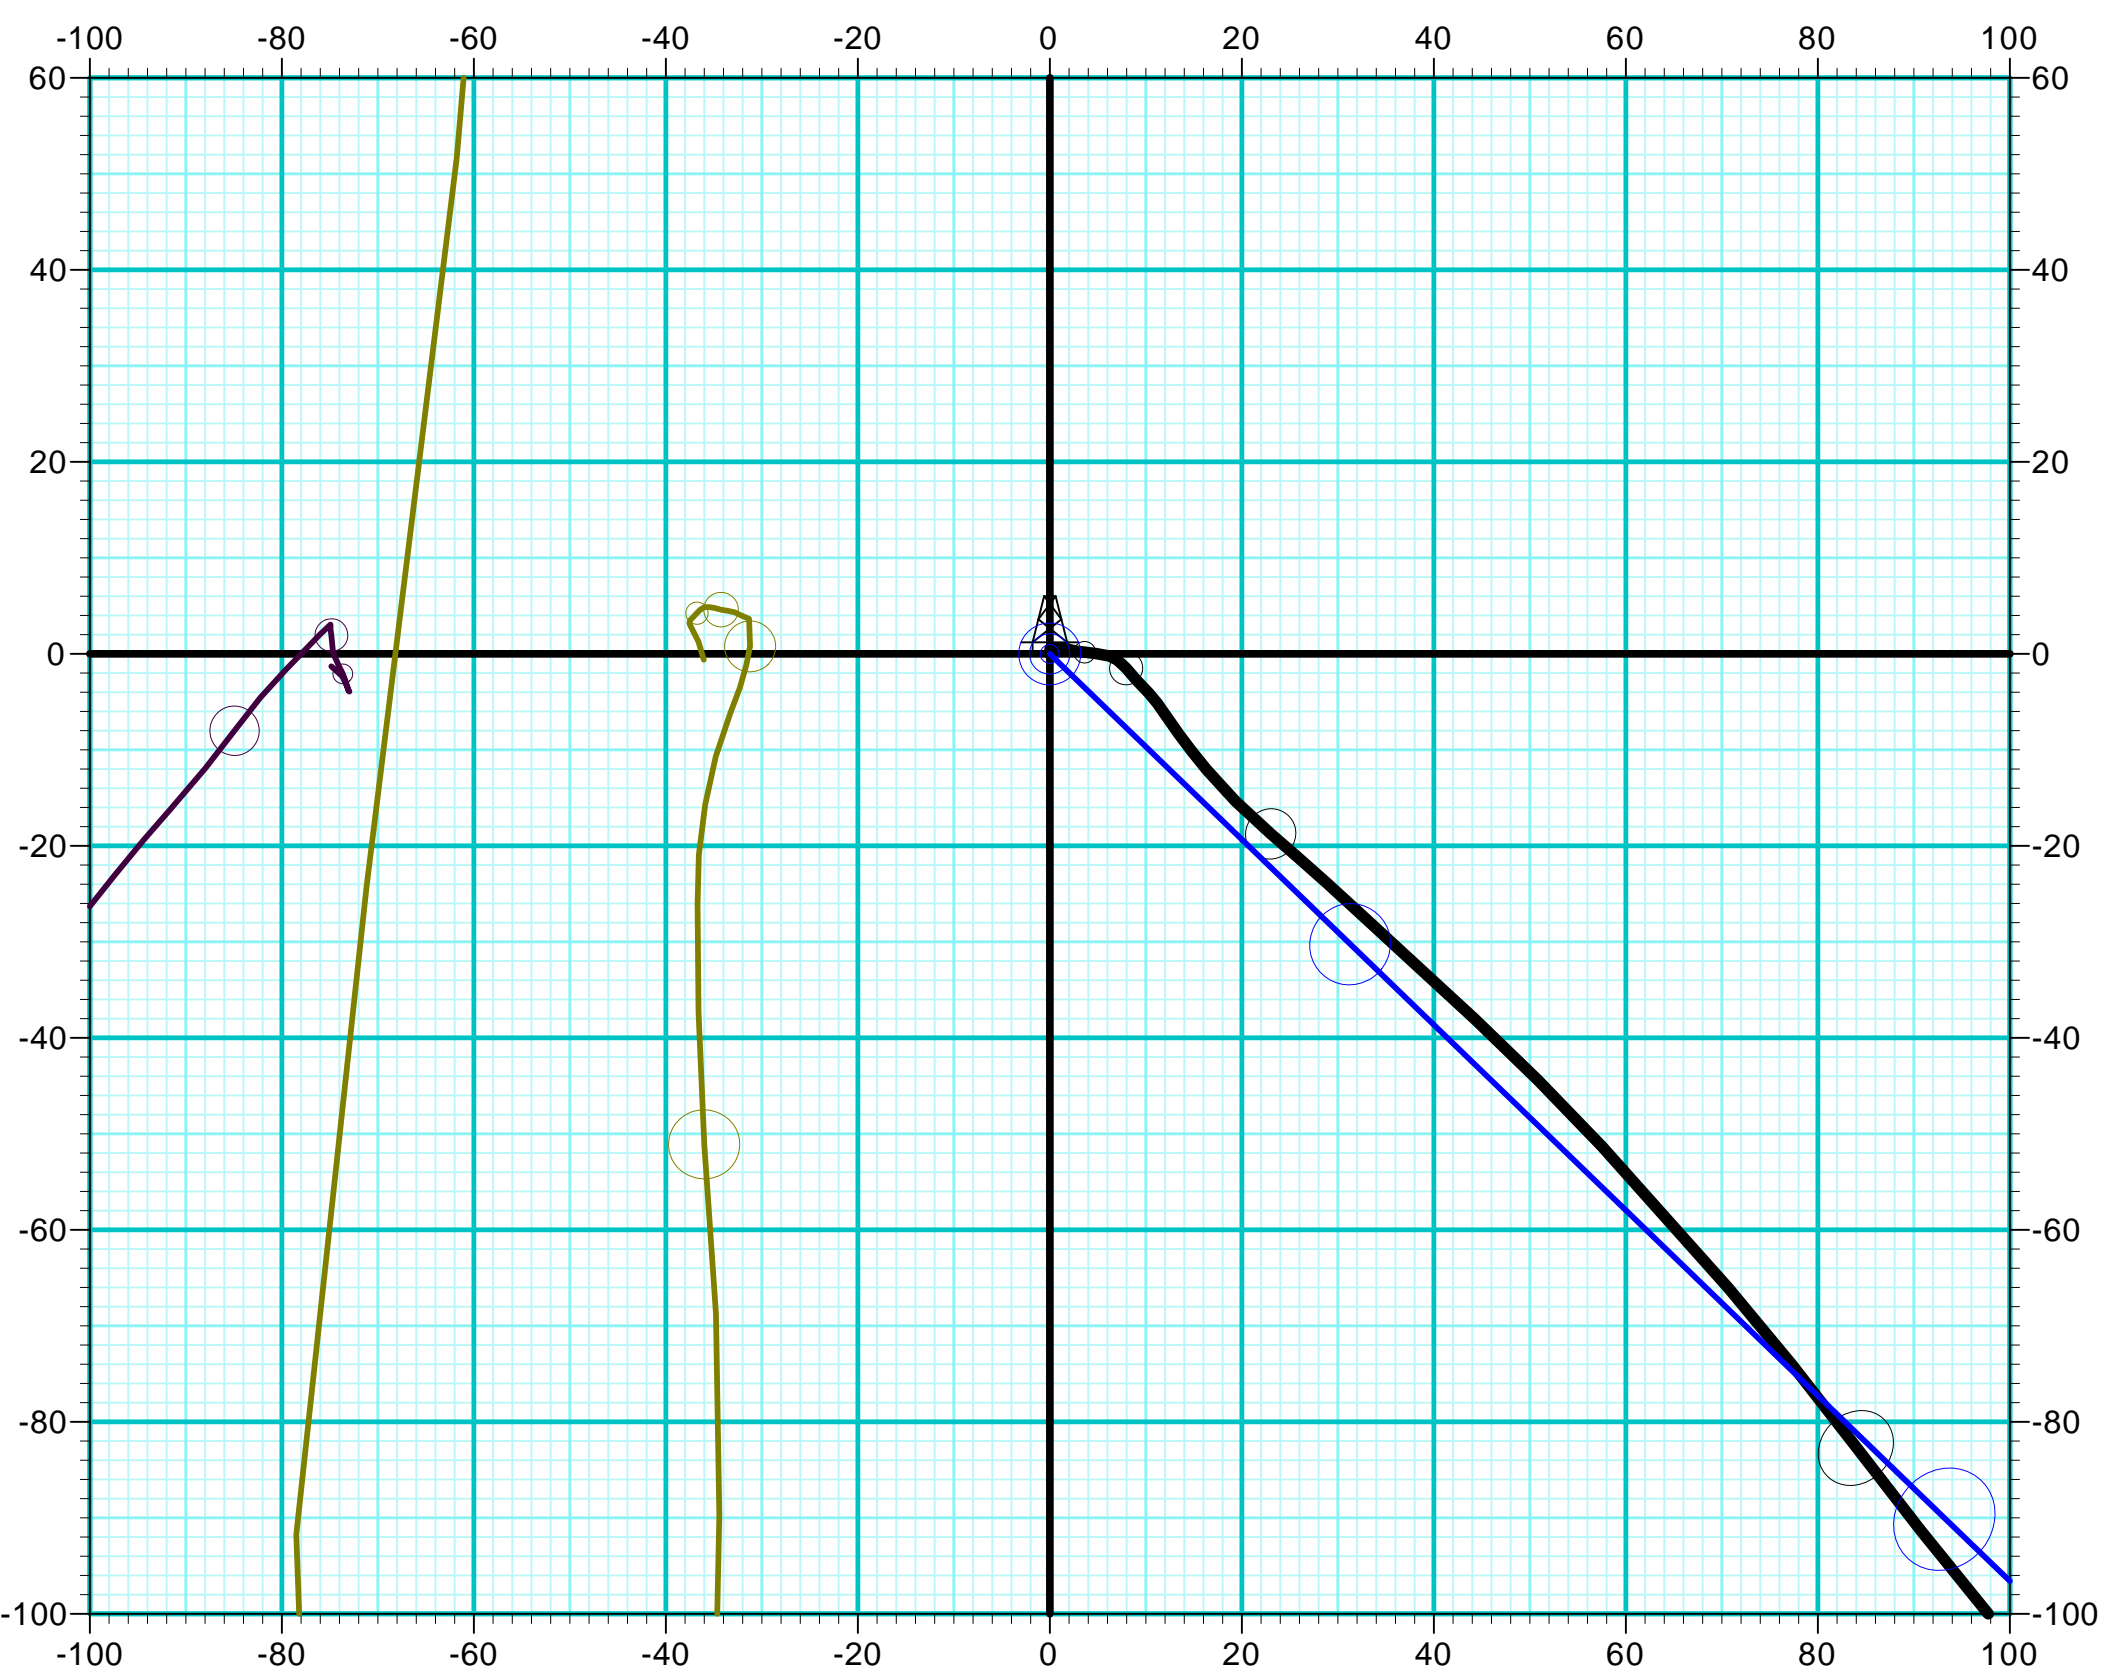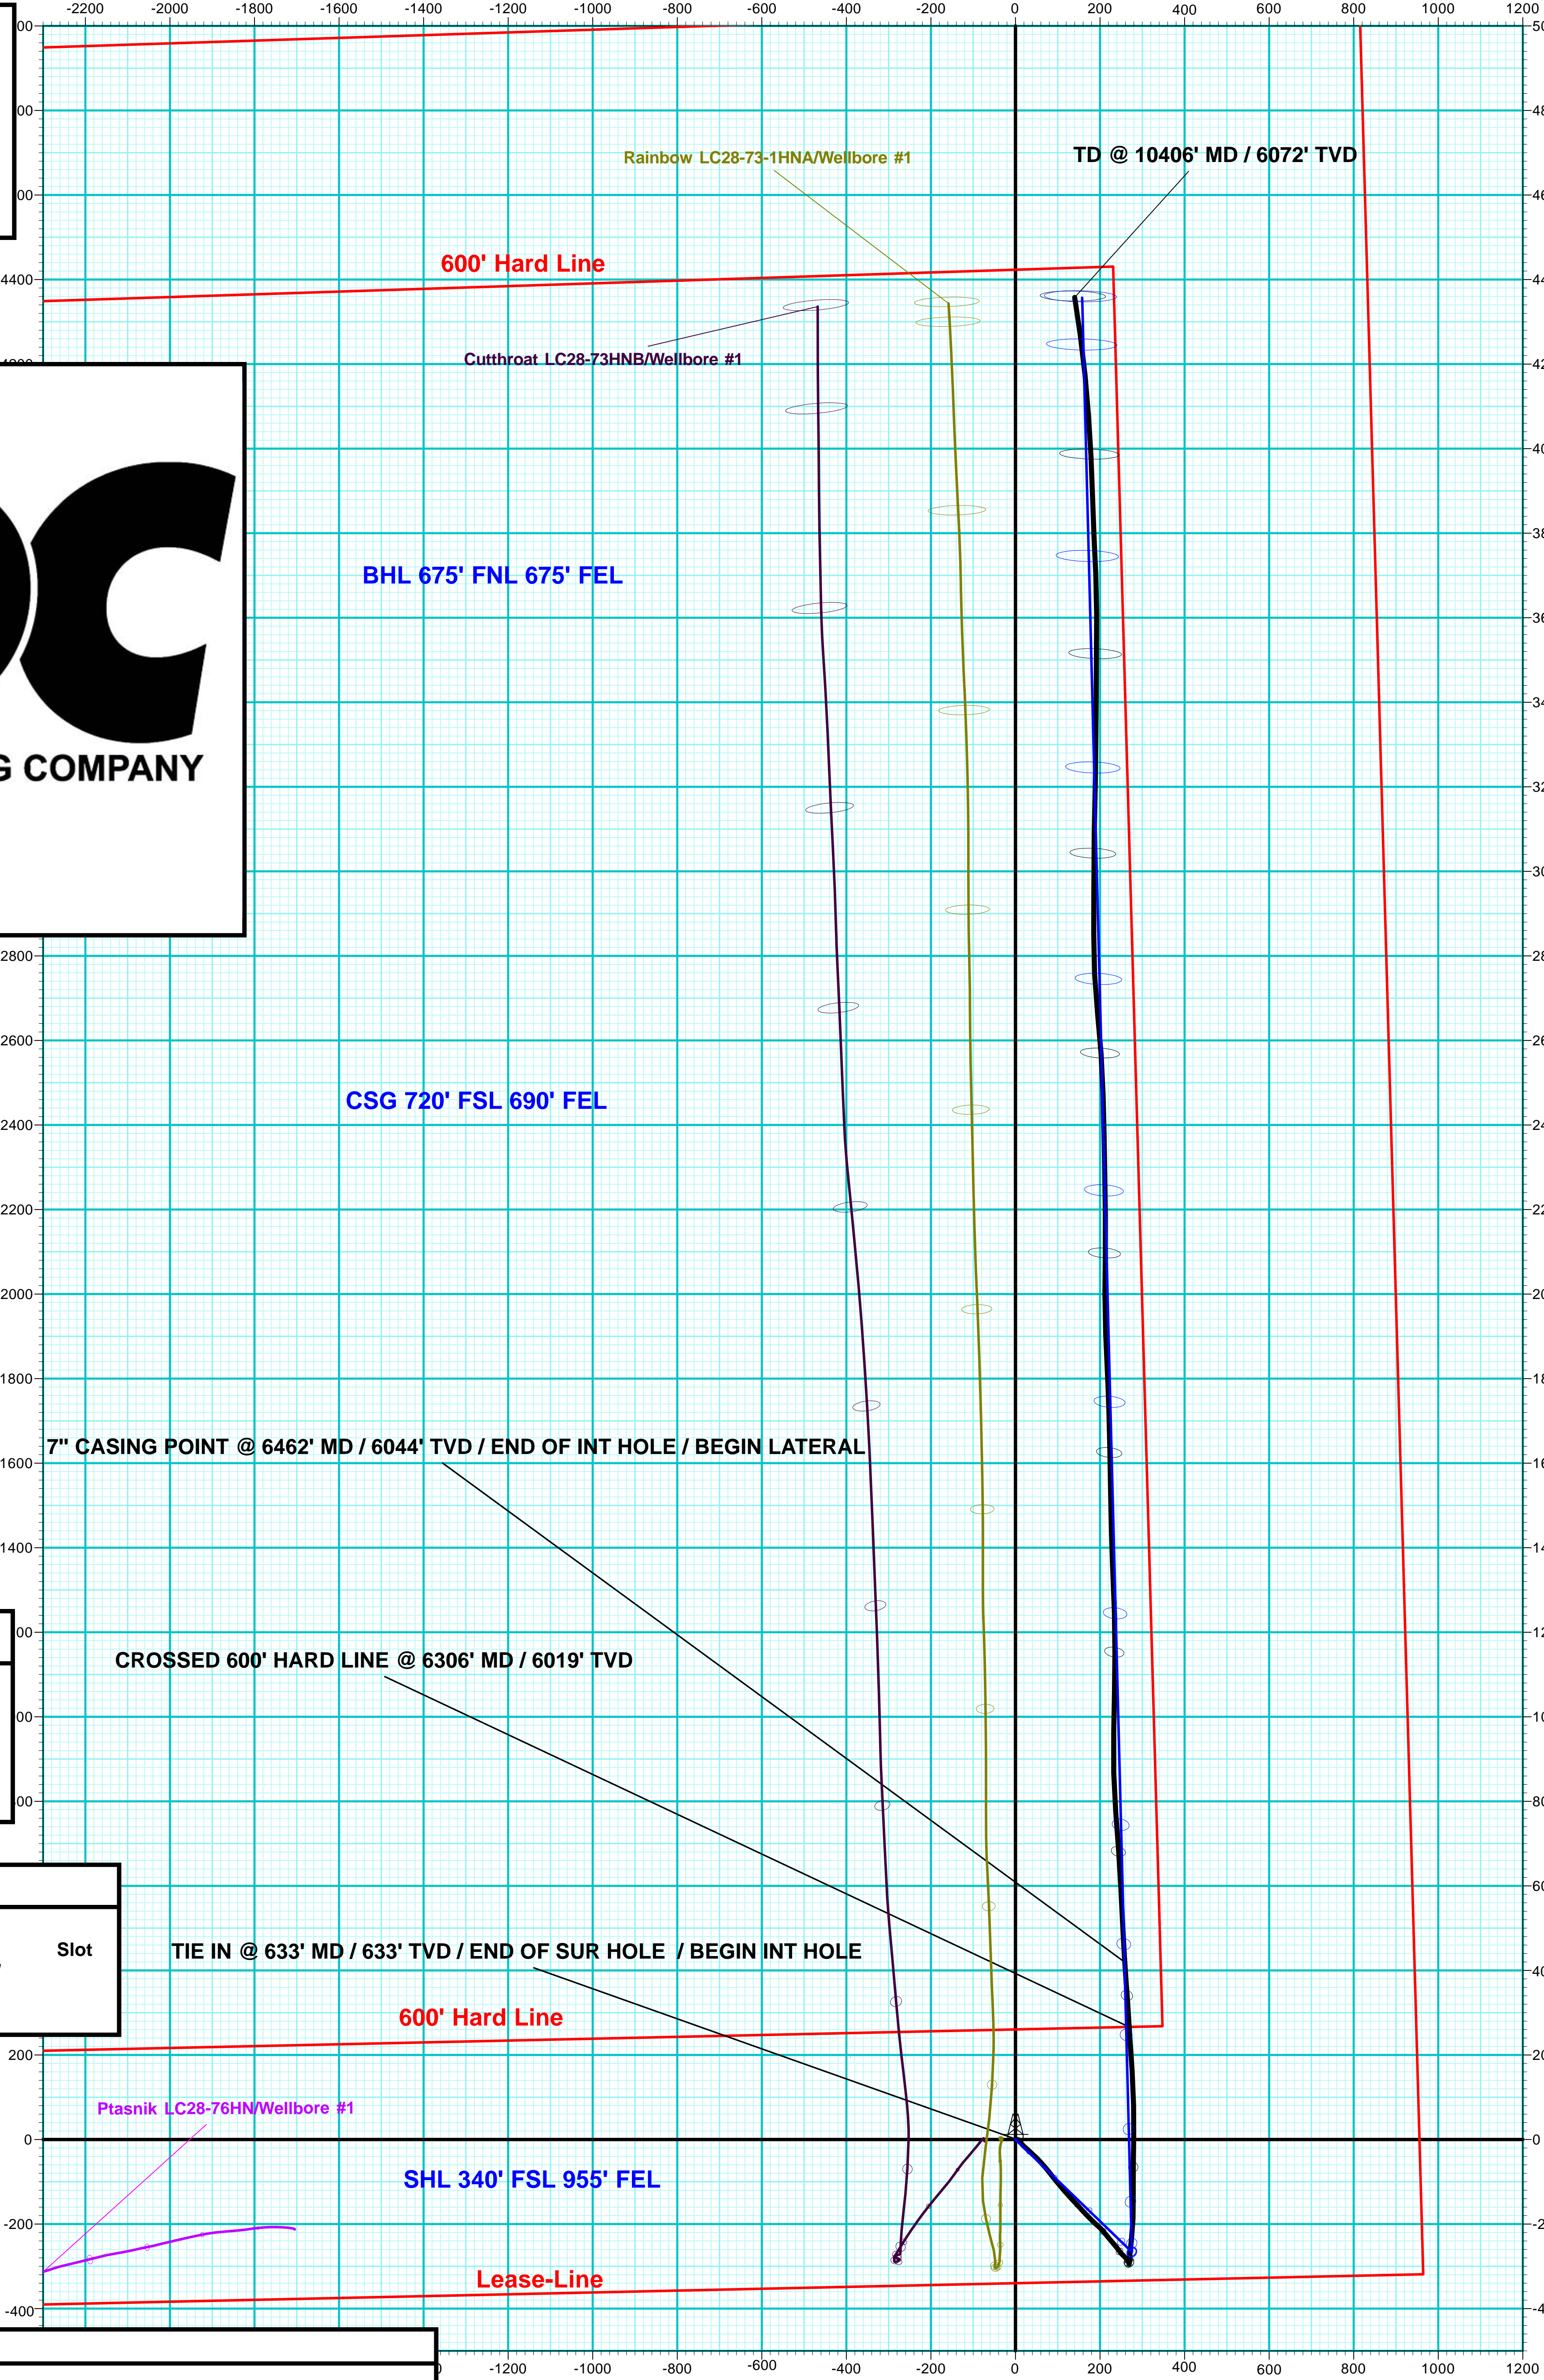

Vertical Section at 2.08° (200 usf/in)