

Current Wellbore Diagram




Daily Operations Report Wellbore Diagram

Well Name:	State of Colorado 2
County, State	Moffat, CO
Legal Description:	SE NW 16-11N-97W
API:	05-081-05704
SHL:	2040' FNL, 1800' FWL
BHL Relative to SHL:	0' N, 0' E
Updated By:	Jeff Bluemel
Date Updated:	7/10/2014
Spud Date:	9/26/1966
TD Date:	10/10/1966
IP Date:	11/1/1966
Well TD:	7,040
Well TVD:	7,040
Orientation:	Vertical
Plug Back MD:	7,012 (1966)
Bridge Plug MD:	
Producing Frac Jobs:	4

Latitude	40.91495
Longitude	-108.29951

As Of Workover	6/17/2014
----------------	-----------

All measurements are in KB
unless otherwise specified.

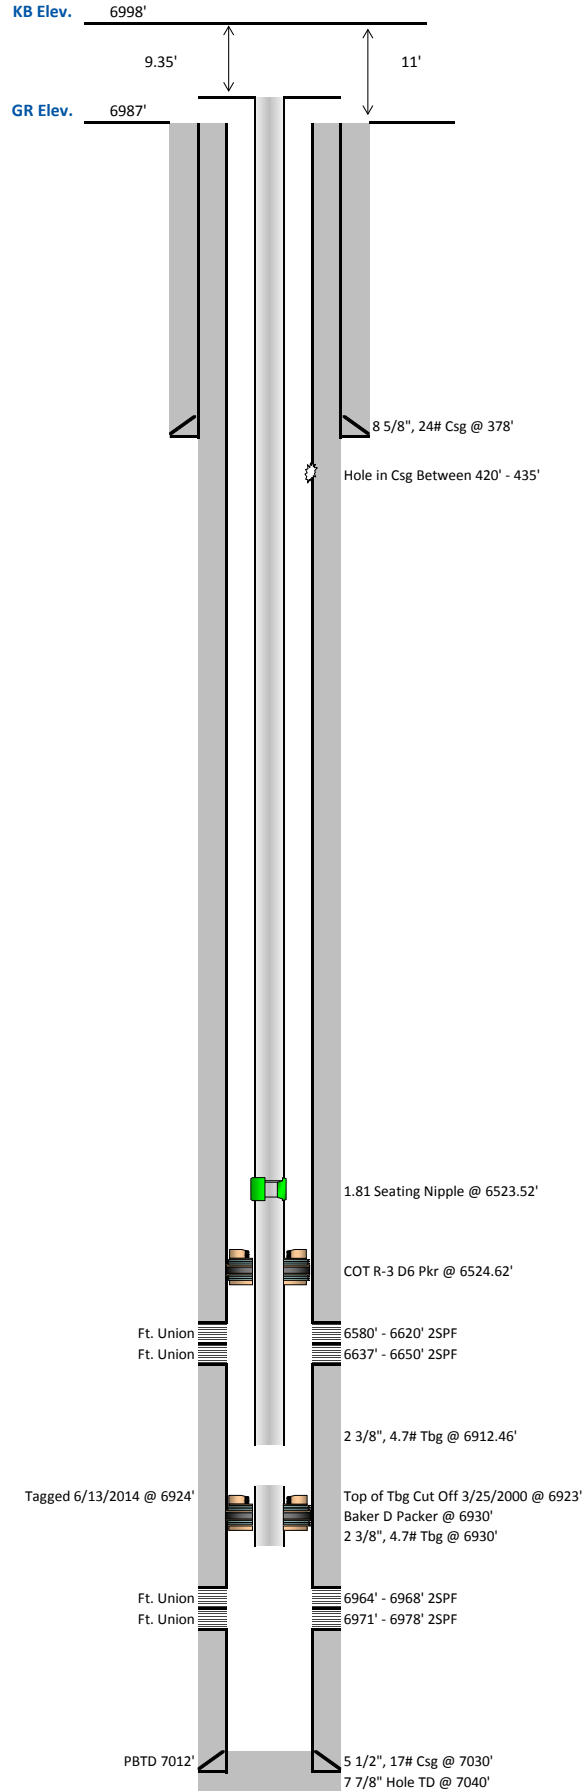

Proposed Wellbore Diagram



Daily Operations Report Wellbore Diagram

Well Name:	State of Colorado 2
County, State	Moffat, CO
Legal Description:	SE NW 16-11N-97W
API:	05-081-05704
SHL:	2040' FNL, 1800' FWL
BHL Relative to SHL:	0' N, 0' E
Updated By:	Jeff Bluemel
Date Updated:	2/10/2015
Spud Date:	9/26/1966
TD Date:	10/10/1966
IP Date:	11/1/1966
Well TD:	7,040
Well TVD:	7,040
Orientation:	Vertical
Plug Back MD:	7,012 (1966)
Bridge Plug MD:	6,900
Producing Frac Jobs:	Surface

Latitude	40.91495
Longitude	-108.29951

As Of P&A	Pending
-----------	---------

All measurements are in KB
unless otherwise specified.

