

Current Wellbore Diagram




Daily Operations Report Wellbore Diagram

Well Name:	Chapman State 2
County, State	Moffat, CO
Legal Description:	SE SW 16-11N-97W
API:	05-081-07013
SHL:	660' FSL, 2080' FWL
BHL Relative to SHL:	0' N, 0' E
Updated By:	Jeff Bluemel
Date Updated:	7/14/2014
Spud Date:	11/17/1966
TD Date:	12/1/1966
IP Date:	12/20/1966
Well TD:	7,150
Well TVD:	7,150
Orientation:	Vertical
Plug Back MD:	6,824
Bridge Plug MD:	6,824
Producing Frac Jobs:	3

Latitude	40.90798
Longitude	-108.29874

As Of Plunger Install	6/9/2014
-----------------------	----------

All measurements are in KB
unless otherwise specified.

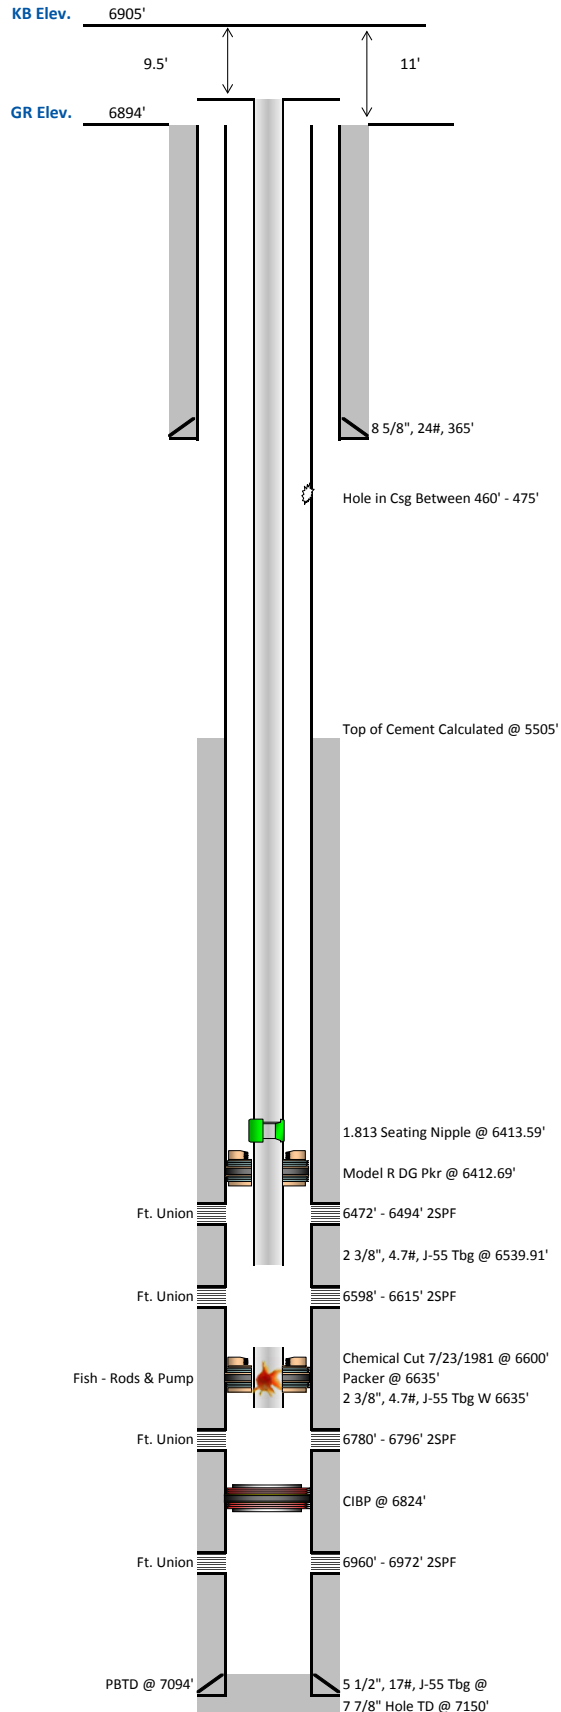

Proposed Wellbore Diagram



Daily Operations Report Wellbore Diagram

Well Name:	Chapman State 2
County, State	Moffat, CO
Legal Description:	SE SW 16-11N-97W
API:	05-081-07013
SHL:	660' FSL, 2080' FWL
BHL Relative to SHL:	0' N, 0' E
Updated By:	Jeff Bluemel
Date Updated:	2/10/2015
Spud Date:	11/17/1966
TD Date:	12/1/1966
IP Date:	12/20/1966
Well TD:	7,150
Well TVD:	7,150
Orientation:	Vertical
Plug Back MD:	Surface
Bridge Plug MD:	6,430
Producing Frac Jobs:	6796

Latitude	40.90798
Longitude	-108.29874

As Of P&A	Pending
----------------------	---------

All measurements are in KB
unless otherwise specified.

