


Noble Energy, INC
State 6525 #11-32
05-123-20367

Current Wellbore Schematic

Status - DA
KB elev - 4680'
GL elev - 4670'

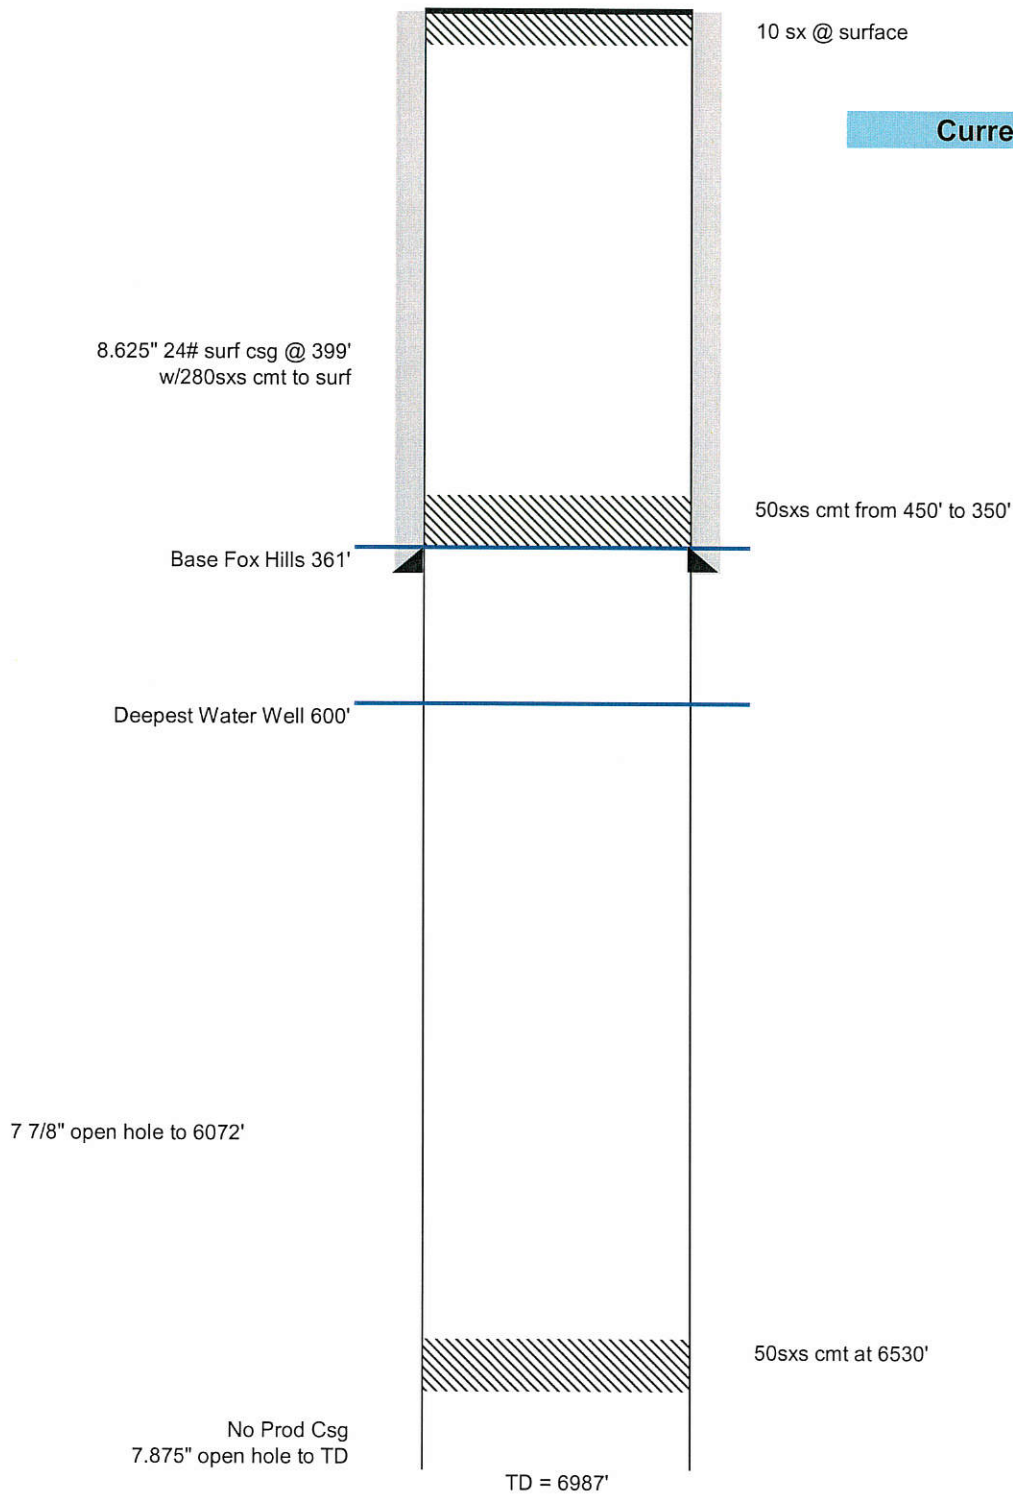

Hunter Dunham
12/12/2014