


CURRENT WELLBORE DIAGRAM

ALLAN # 1

API # 05-123-05775

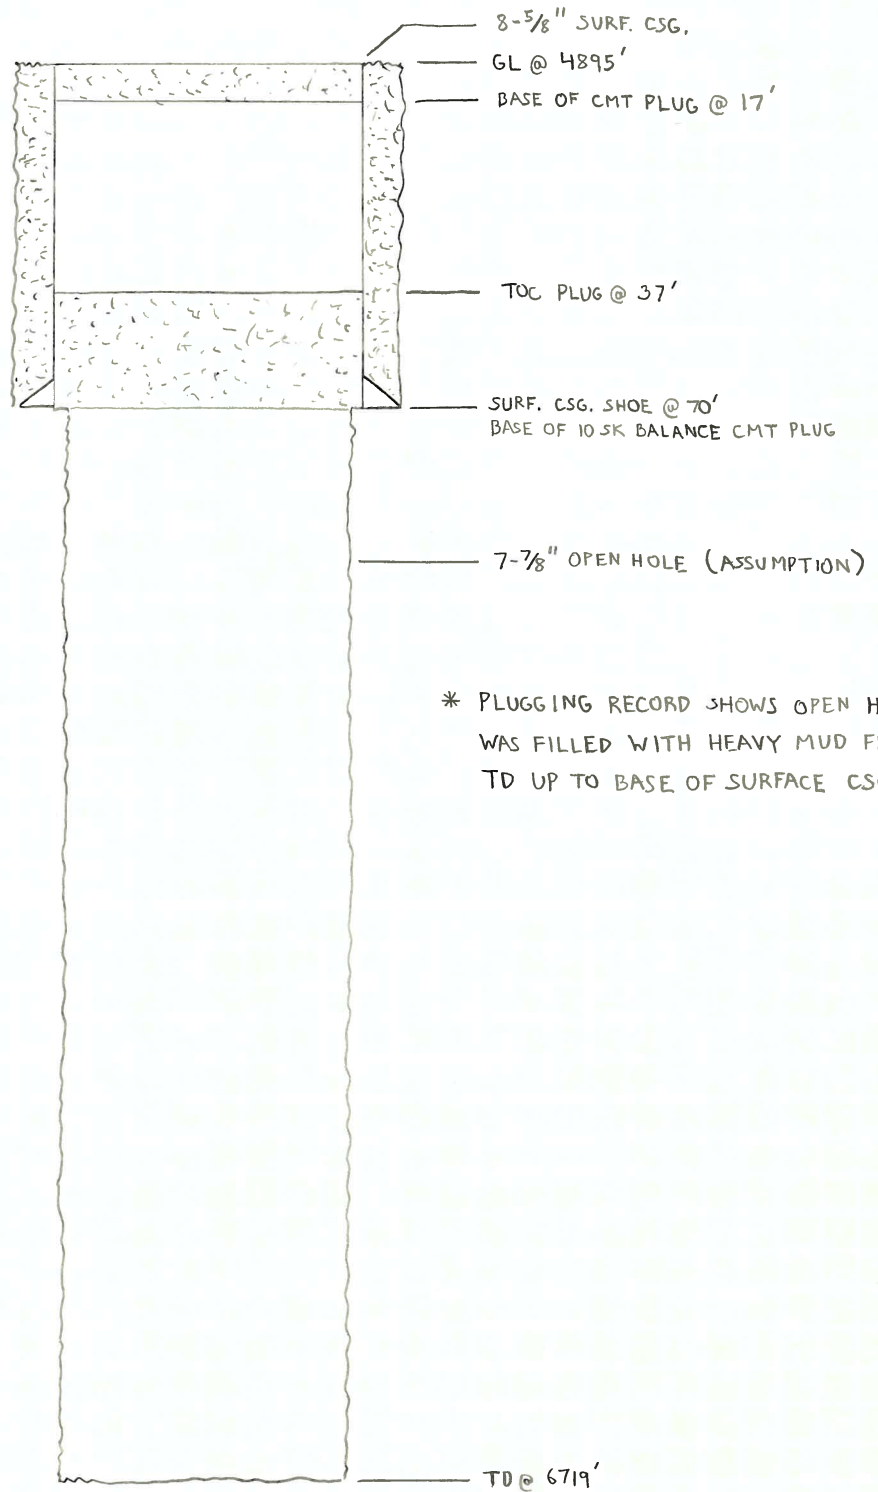

 - EXISTING CMT

\* PLUGGING RECORD SHOWS OPEN HOLE  
WAS FILLED WITH HEAVY MUD FROM  
TD UP TO BASE OF SURFACE CSG,

AMPAD<sup>®</sup>