

KERR-MCGEE OIL AND GAS ONSHORE LP

THOMASON X 16-3

NE NW 16 2N 65W 662' FNL 1,966' FWL

WELD,COLORADO

02/17/2015

AREA: E2

ROUTE: E22 Spud: 08/12/1993

WINS No.: 87986

AFE/WO#: 2102131

API#: 0512317205

GL: 4880

KB: 4891

MTD: 7821


TVD: 7821

LOG MD:

PBMD: 7809

PBTVD: 7809

Directions: CR 22 & CR 41 E 2/10, S 1/10, E 1/10 INTO

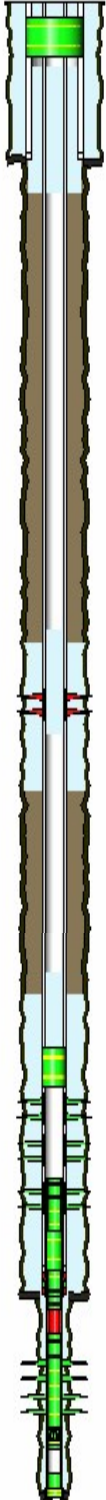

HOLE SECTIONS	Size	Top	Btm	TD Date
SURFACE	12.25	11	834	08/13/1993
PRODUCTION	7.88	834	7370	08/18/1993
LINER	2.75	7370	7821	06/16/2007

TUBULARS	Tool Type	Joints	Size	Weight	Grade	Thread	Top D	Bottom D
SURFACE CASING	Casing	18	8.62	24.00			11	820
	Casing	1	8.62				820	821
PRODUCTION CASING	Casing	176	3.50	7.70	M-75	10 RD	11	7367
	Crossover	1	3.50				7367	7368
	Casing Float Collar	1	3.50				7368	7368
	Shoe Joint	1	3.50				7368	7369
	Casing Float Shoe	1	3.50				7369	7370
PRODUCTION LINER	Liner	10	2.38	4.70	N-80	CS HYDRIL	7170	7465
	Pup Joint	1	2.38		N-80		7465	7499
	Liner	10	2.38	4.70	N-80	CS HYDRIL	7499	7810
	Crossover	1	2.38				7810	7811
	Shoe Joint	1	2.38	4.70	N-80	10 RD	7811	7817
	Liner	1	2.75				7817	7817
FISH	Fish	1	1.69				7766	7767
BRIDGE PLUG	Cast Iron Bridge Plu	1	3.50				6925	6927
BRIDGE PLUG	Cast Iron Bridge Plu	1	2.38				7340	7341
BRIDGE PLUG	Cast Iron Bridge Plu	1	8.63				80	83

CEMENT JOBS	Stage	Sacks	Cement Jobs	Top D	Btm D	cbi
SURFACE CASING	PRIM CMT 1ST STAGE	322	Lead CEMENT	11	821	No
PRODUCTION CASING	PRIM CMT 2ND STAGE	235	Lead	4250	5100	Yes
	PRIM CMT 1ST STAGE	160	Tail	6550	7370	Yes
PRODUCTION CASING	SQUEEZE JOB	150	Lead CEMENT	4578	4600	Yes
PRODUCTION LINER	PRIM LINER CEMENT	11	Lead CEMENT	7562	7817	Yes
PRODUCTION LINER	REMEDIAL CEMENT S	10	LEAD CEMENT	7194	7562	Yes
PRODUCTION CASING	ABANDONMENT PLUC			6390	6920	No
	ABANDONMENT PLUC	25	LEAD FRESH WATER	4160	47	No
SURFACE CASING	ABANDONMENT PLUC	200	LEAD FRESH WATER	357	1051	No
SURFACE CASING	ABANDONMENT PLUC	50	LEAD FRESH WATER	11	80	No

PERFORATIONS	Formation	Zone	Top	Btm	Date	Reason	Comments
	SUSSEX		4578	4600	08/11/1994	PRODUCTION	-- [WV Data Migration]
	NIOBARRA		6978	7000	06/30/2005	PRODUCTION	-- [WV Data Migration]

KERR-MCGEE OIL AND GAS ONSHORE LP

THOMASON X 16-3

NE NW 16 2N 65W 662' FNL 1,966' FWL

WELD,COLORADO

02/17/2015

AREA: E2

ROUTE: E22

Spud: 08/12/1993

WINS No.: 87986

AFE/WO#: 2102131

API#: 0512317205

GL: 4880KB: 4891MTD: 7821TVD: 7821LOG MD:PBMD: 7809PBTVD: 7809Directions:

CR 22 & CR 41 E 2/10, S 1/10, E 1/10 INTO

NIOBRARA	7080	7088	06/30/2005	PRODUCTION	-- [WV Data Migration]
CODELL	7211	7226	08/21/1993	PRODUCTION	-- [WV Data Migration]
CODELL	7212	7226	07/15/2003	PRODUCTION	-- [WV Data Migration]
	7559	7560	08/15/2007	CEMENT SQUEEZE	
J SAND	7654	7662	08/20/2007	PRODUCTION	-- [WV Data Migration]
J SAND	7682	7690	08/20/2007	PRODUCTION	-- [WV Data Migration]

Comments: