


See Detail

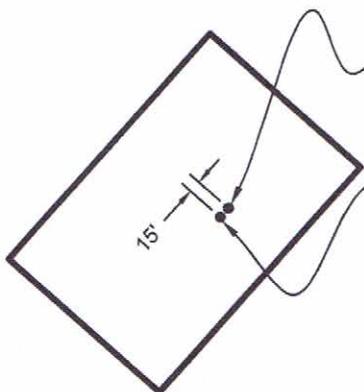

**SURFACE LOCATION DETAIL:**  
Not to Scale

**Hughes 11-90-26 #2** (vertical):  
Surface Location (existing)  
39.06833° N 1642 FSL  
107.41928° W 1473 FWL

**Hughes 11-90-26 #3** (vertical):  
Surface Location  
39.06836° N 1653 FSL  
107.41926° W 1483 FWL

**Note:**  
~ FNL, FSL, FEL and FWL is the footage to the nearest section line measured perpendicularly. (i.e. feet North to Line)  
~ Horizontal Datum = NAD83

**LEGEND**

- ◆ ~ FOUND ORIGINAL STONE
- ⊕ ~ FOUND GLO BRASS CAP ON STEEL POST
- ⊕ ~ FOUND REBAR AND CAP BY LS15710
- ~ FOUND No.6 REBAR WITH A 2 1/2" ALUMINUM CAP, LS24963
- ~ WELL FEATURES



Scale: 1" = 1000 U.S. Survey feet

**MULTIWELL LOCATION PLAT**

HUGHES 11-90-26 #2 & #3  
Located in the SW 1/4 of Section 26,  
Township 11 South, Range 90 West, 6th P.M.,  
Gunnison County, Colorado

SURVEYED BY: DGN	DWG DATE: 01/19/15	<b>David G. Nicewicz, PLS</b> <small>cell: (720) 458-1104 david.nicewicz@urs.com</small>	<small>AECOM 804 Colorado Ave, Suite 201 Glenwood Springs Co 81610</small>
DRAFTED BY: MLD	SCALE: 1" = 1000'		
JOB NO.: 22244264.40100		SHEET NO. 1 of 1	