




**Lease Name:** Howard 2-27

**Legals:** NWNE 27 6N 64W

**County:** Weld County, Colorado

**API#:** 05-123-13325

## Plugged & Abandoned

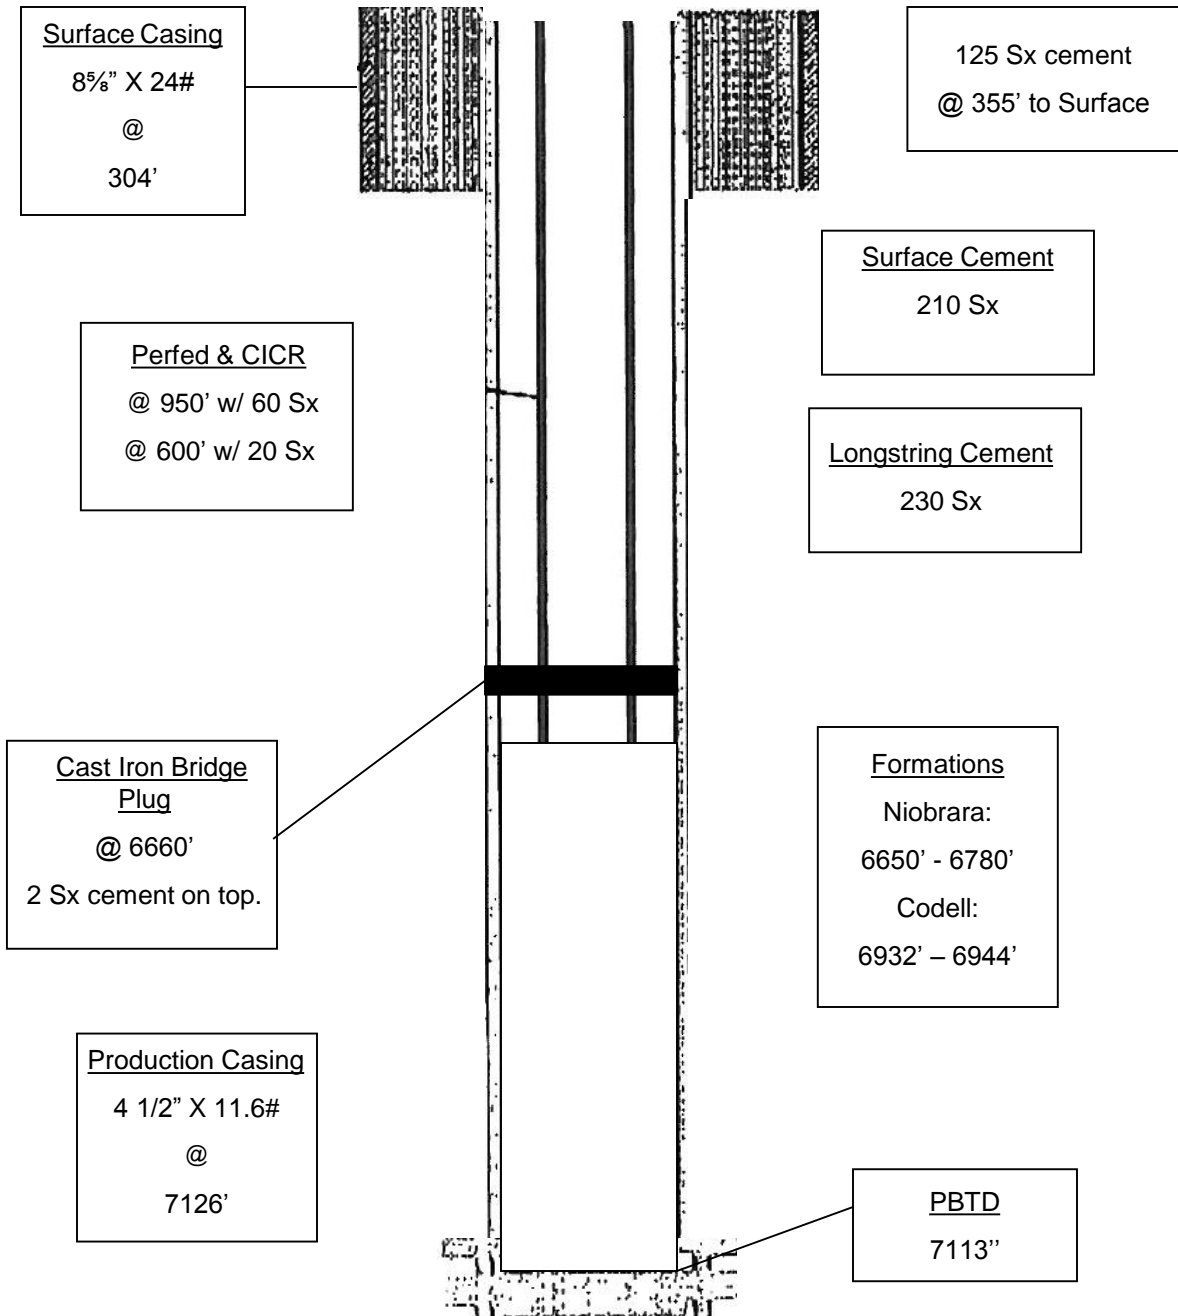

## Wellbore Diagram