




Job Number: 12082014
Company: Nighthawk
Lease/Well: Keystone 3-7
Location: Genoa
Rig Name: Extreme 11
State/County: COLORADO/ Lincoln
Country: USA
API Number:

Elevation (To MSL): 5328.00 ft
RKB: 0.00 ft
Projection System: US State Plane 1983
Projection Group: Colorado Central Zone
Projection Datum: GRS80
Magnetic Declination: 7.61
Grid Convergence: 1.27219 E
Date: Saturday, December 20, 2014

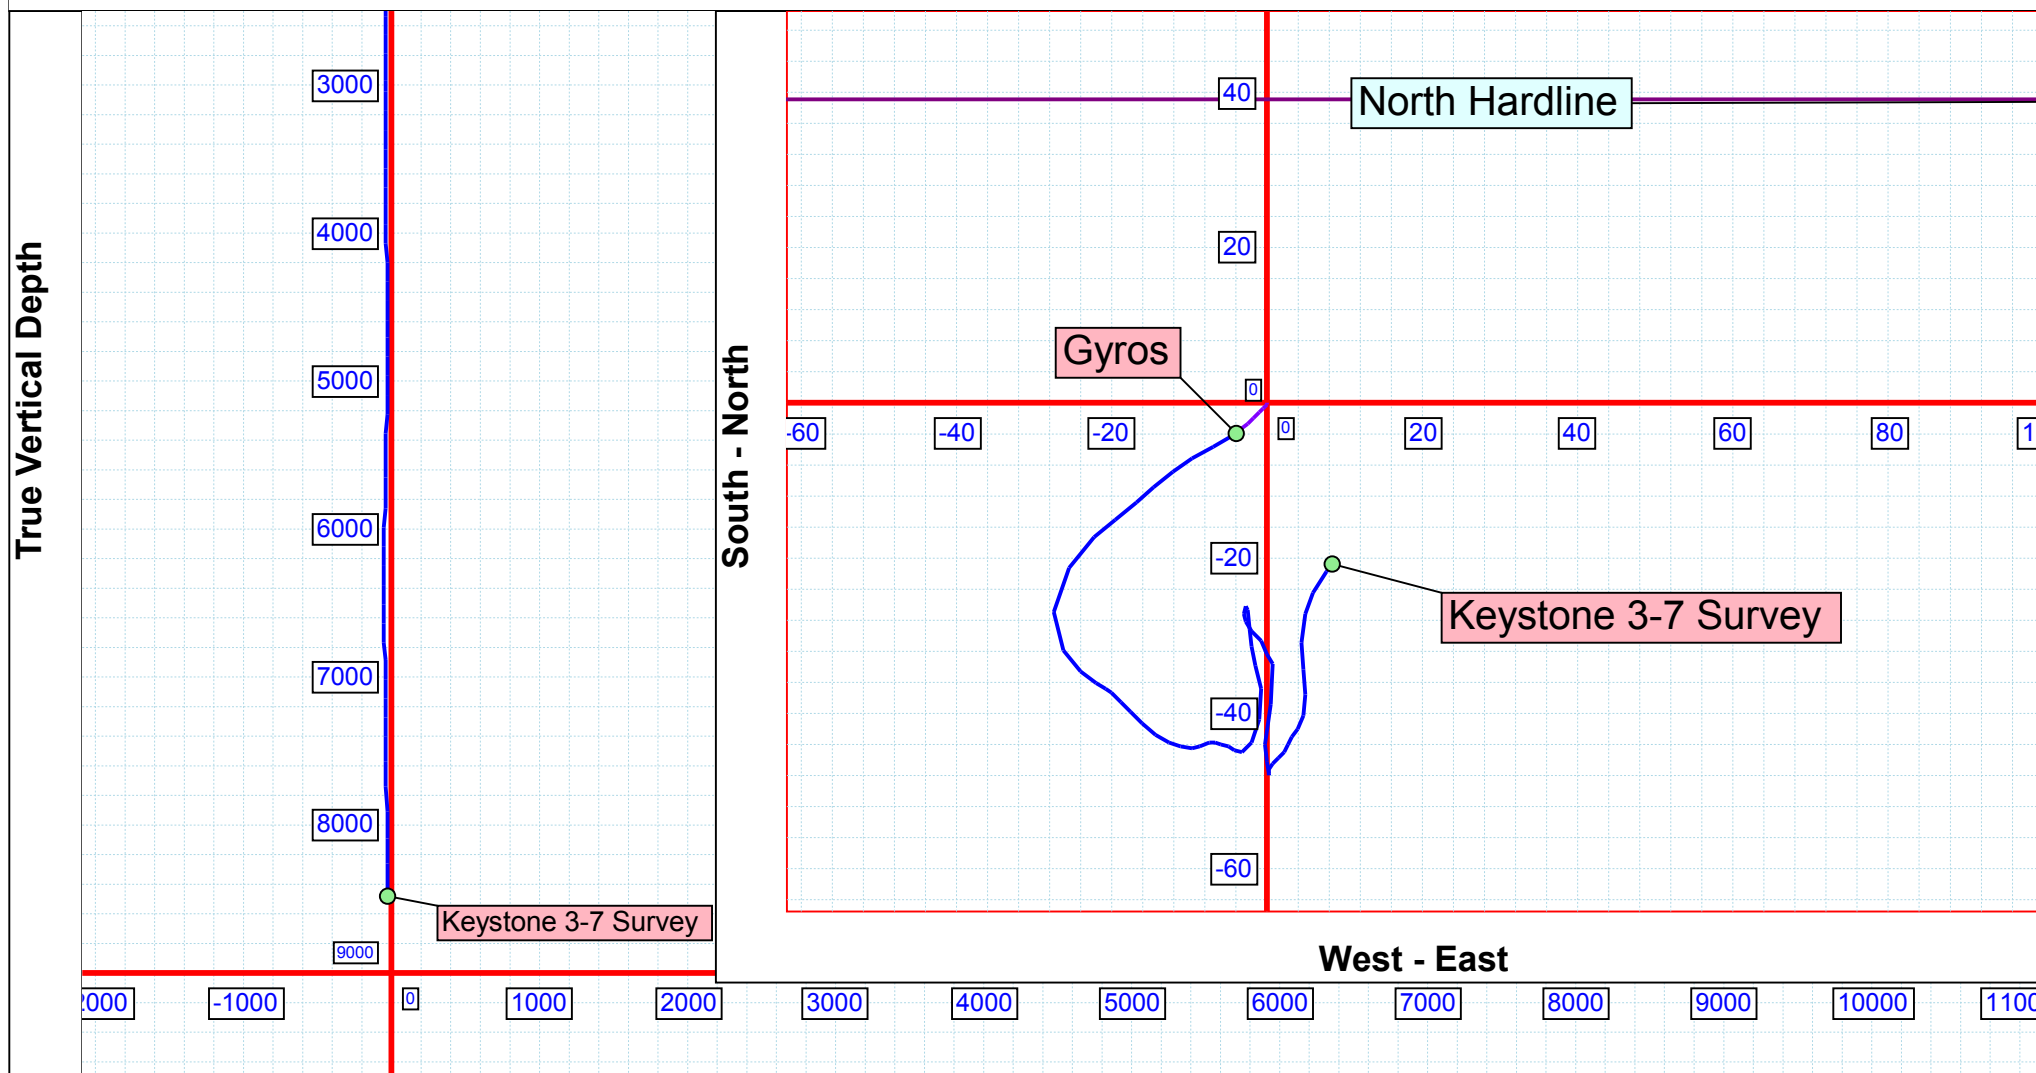

Vertical Section (1000 Ft/Div) VSP: 0.00°