


KERR-MCGEE OIL AND GAS ONSHORE LP
BELL L 12-21
C -- 12 3N 66W 2,548' FNL 2,671' FWL
WELD,COLORADO
02/23/2015

AREA: N1 ROUTE: N11 Spud: 06/20/1992 WINS No.: H5070 AFE/WO#: 2102257 API#: 0512315851

GL: 4975 KB: 4988 MTD: 7532 TVD: 7532 LOG MD: 7476 PBMD: 7488 PBTVD: 7488

Directions: CR 36 & CR 35 S 50°, E 3/10, S 5/10, E 1/10 INTO

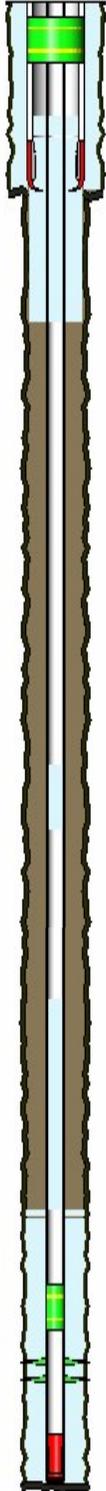

<u>HOLE SECTIONS</u>		<u>Size</u>	<u>Top</u>	<u>Btm</u>	<u>TD Date</u>				
SURFACE		12.25	13	580	06/20/1992				
PRODUCTION		7.88	580	7532	06/25/1992				
<u>TUBULARS</u>		<u>Tool Type</u>	<u>Joints</u>	<u>Size</u>	<u>Weight</u>	<u>Grade</u>	<u>Thread</u>	<u>Top D</u>	<u>Bottom D</u>
SURFACE CASING		Casing	13	8.62	24.00	?		13	558
		Casing Guide Shoe	1	8.62				558	560
PRODUCTION CASING		Casing	236	2.87	6.50	?		13	7512
		Casing Guide Shoe	1	2.88				7512	7514
BRIDGE PLUG		CIBP With CMT Cap	1	2.88		10k		7300	7301
BRIDGE PLUG		Cast Iron Bridge Plu	1	8.63		10K		80	82
<u>CEMENT JOBS</u>		<u>Stage</u>	<u>Sacks</u>	<u>Cement Jobs</u>		<u>Top D</u>	<u>Btm D</u>	<u>cbl</u>	
SURFACE CASING			300	LEAD		13	560	No	
PRODUCTION CASING			225	LEAD		6900	7514	Yes	
PRODUCTION CASING		ABANDONMENT PLUC	110	LEAD	FRESH WATER	6840	6885	No	
PRODUCTION CASING		ABANDONMENT PLUC	20	LEAD	FRESH WATER	5547	6840	No	
PRODUCTION CASING		ABANDONMENT PLUC	260	LEAD	FRESH WATER	4100	4500	No	
SURFACE CASING		ABANDONMENT PLUC	480	LEAD	FRESH WATER	545	1370	No	
SURFACE CASING		ABANDONMENT PLUC	40	LEAD	FRESH WATER	545	545	No	
SURFACE CASING		ABANDONMENT PLUC	75	LEAD	FRESH WATER	460	540	No	
<u>PERFORATIONS</u>		<u>Formation</u>	<u>Zone</u>	<u>Top</u>	<u>Btm</u>	<u>Date</u>	<u>Reason</u>	<u>Comments</u>	
		CODELL		4500	4501	01/14/2015	CEMENT SQUEEZE		
		NIOBRARA		6885	6886	01/12/2015	CEMENT SQUEEZE		
		CODELL		7372	7372	07/05/1992	PRODUCTION		
		CODELL		7412	7425	06/01/2004	PRODUCTION	REPERF & REFRAC CODELL	
		CODELL		7414	7424	07/05/1992	PRODUCTION		

Comments: