

**KERR-MCGEE OIL AND GAS ONSHORE LP**

**DECHANT X 19-5**

**SW NW 19 2N 65W 1,880' FNL 660' FWL**

**WELD,COLORADO**

**02/23/2015**

**AREA: E2**

**ROUTE: E22**

**Spud: 01/29/2008**

**WINS No.: C0778**

**AFE/WO#: 2102487**

**API#: 0512325385**

**GL: 5018**

**KB: 5031**

**MTD: 8064**


**TVD: 8063**

**LOG MD: 8053**

**PBMD: 8033**

**PBTVD:**

**Directions: CR 20 & CR 37, S 2/10, SE 100'(EDGE OF FIELD), 200', E INTO. NO LEASE ROAD**

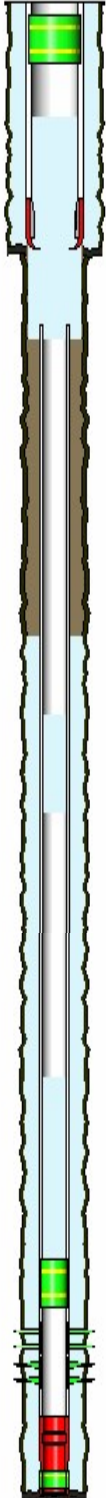

<u>HOLE SECTIONS</u>	<u>Size</u>	<u>Top</u>	<u>Btm</u>	<u>TD Date</u>					
SURFACE	12.25	13	1000	01/30/2008					
PRODUCTION	7.88	1000	8064	02/01/2008					
<u>TUBULARS</u>	<u>Tool Type</u>	<u>Joints</u>	<u>Size</u>	<u>Weight</u>	<u>Grade</u>	<u>Thread</u>	<u>Top D</u>	<u>Bottom D</u>	
SURFACE CASING	Casing	23	8.62	24.00	J-55		13	989	
	Casing Guide Shoe	1	8.62		J-55		989	990	
BRIDGE PLUG	Cast Iron Bridge Plu	1	4.00				7780	7781	
PRODUCTION CASING	Casing	156	4.50	11.60	M-80		1500	8032	
	Casing Float Collar	1	4.50				8032	8033	
	Shoe Joint	1	4.50	11.60	M-80		8033	8049	
	Casing Float Shoe	1	4.50				8049	8050	
BRIDGE PLUG	Cast Iron Bridge Plu	1	7.88				80	83	
<u>CEMENT JOBS</u>	<u>Stage</u>	<u>Sacks</u>	<u>Cement Jobs</u>				<u>Top D</u>	<u>Btm D</u>	<u>cbl</u>
SURFACE CASING	PRIM CMT 1ST STAGE	475	Lead	50/50 POZ-MIX			13	990	No
PRODUCTION CASING	PRIM CMT 1ST STAGE	380	LEAD	50/50 POZ-MIX			3590	5340	Yes
	PRIM CMT 1ST STAGE	90	MIDDLE	50/50 POZ-MIX			5340	6670	Yes
	PRIM CMT 1ST STAGE	230	TAIL	50/50 POZ-MIX			6670	8050	Yes
PRODUCTION CASING	ABANDONMENT PLUC	70	LEAD	FRESH WATER			6560	7775	No
PRODUCTION CASING	ABANDONMENT PLUC	50	LEAD	FRESH WATER			4119	4780	No
PRODUCTION CASING	ABANDONMENT PLUC	360	LEAD	FRESH WATER			436	1600	No
<u>PERFORATIONS</u>	<u>Formation</u>	<u>Zone</u>	<u>Top</u>	<u>Btm</u>	<u>Date</u>	<u>Reason</u>	<u>Comments</u>		
	J SAND		7867	7881	02/15/2008	PRODUCTION			
	J SAND		7896	7908	02/15/2008	PRODUCTION			

**Comments:**