

**WPX Energy Rocky Mountain LLC**

**MEAD RWF 332-23**


**RULISON Field**

**SHL: 2293' FSL 249' FEL (NE/4 SE/4) Section 23 T6S R94W 6th PM**

**BHL: 2012' FNL 1812' FEL (SW/4 NE/4) Section 23 T6S R94W 6th PM**

**Garfield County Colorado**

**Formation Tops**  
(Measured Depths)

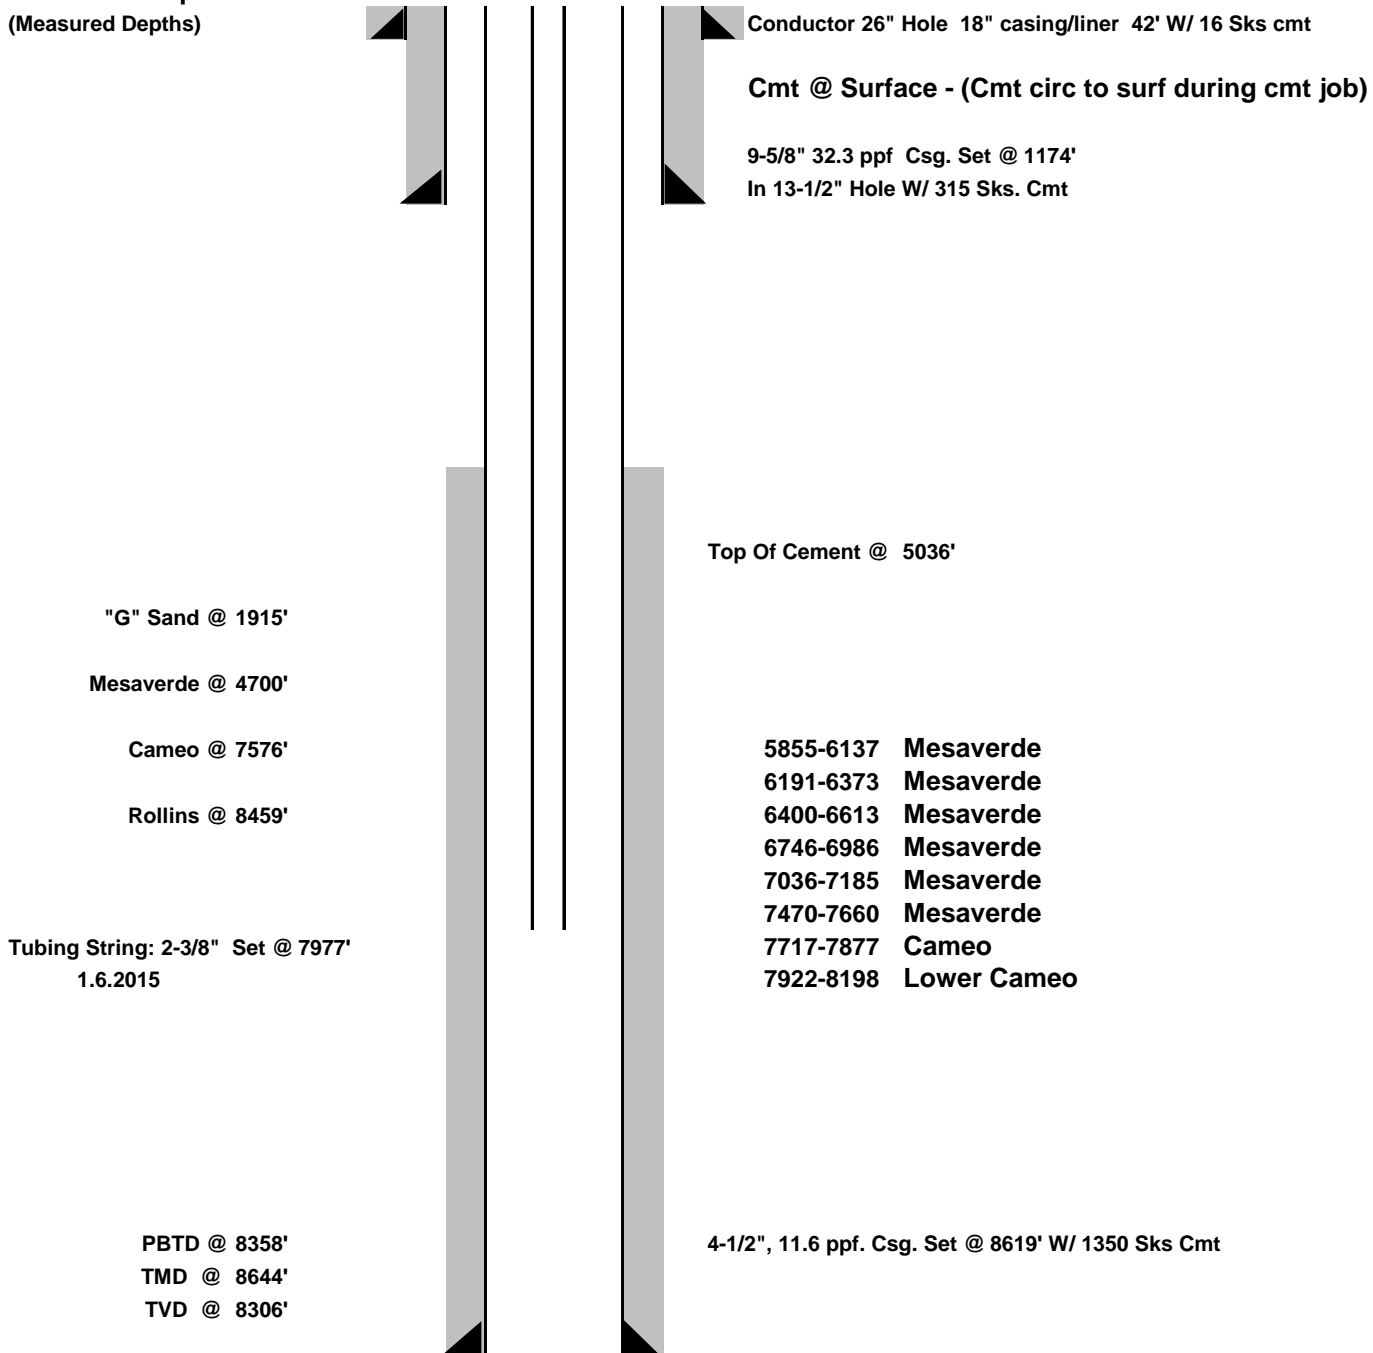

**DATE CREATED: 2.3.2015**

**NOTE: THIS IS NOT TO SCALE.**  
**\*\*FINAL\*\***