




Lat40°, Inc. 6250 W. 10th Street, Unit 2, Greeley, CO 970-515-5294

WELL LOCATION CERTIFICATE

STATE SEVENTY HOLES U41-Y44-6HNC

SECTION: 6
TOWNSHIP: 4N
RANGE: 62W
6TH. P.M.
WELD COUNTY, CO

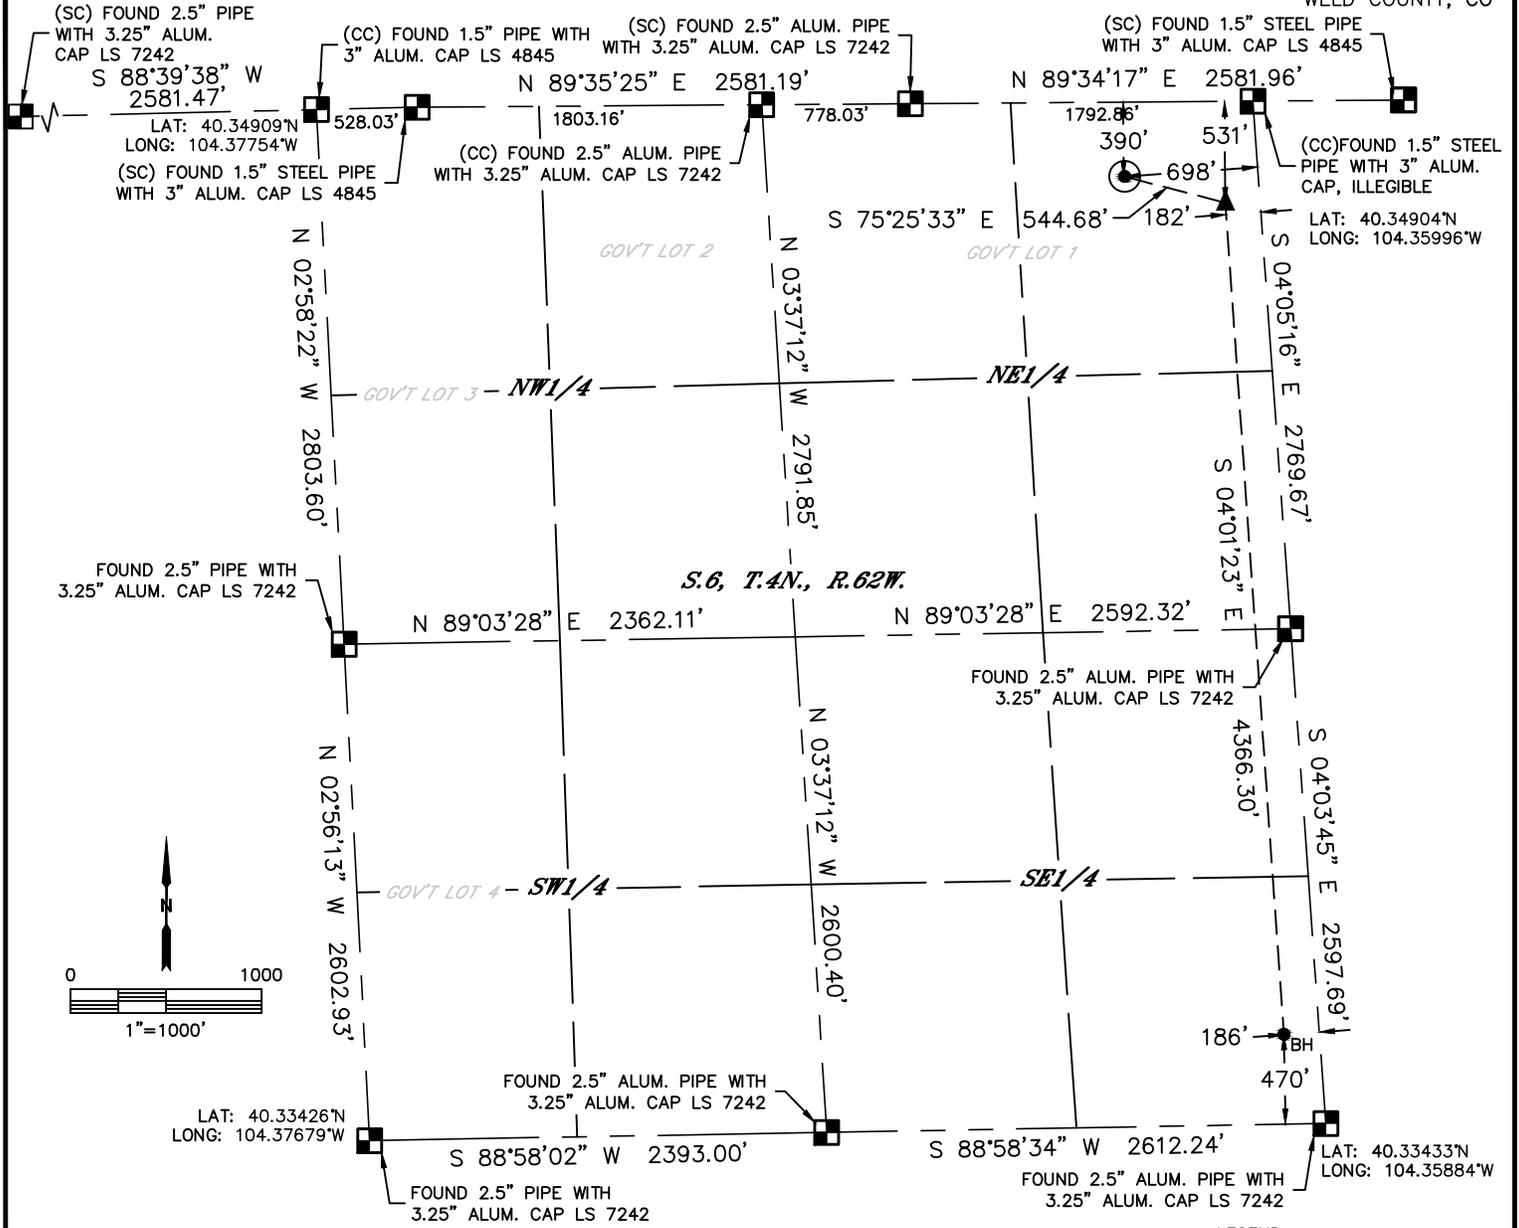

(SC) FOUND 1.5" STEEL PIPE WITH 3" ALUM. CAP LS 4845
LAT: 40.34904°N
LONG: 104.35996°W

(SC) FOUND 2.5" PIPE WITH 3.25" ALUM. CAP LS 7242
S 88°39'38" W 2581.47'
LAT: 40.34909°N
LONG: 104.37754°W

(CC) FOUND 1.5" PIPE WITH 3" ALUM. CAP LS 4845
N 89°35'25" E 2581.19'
(CC) FOUND 2.5" ALUM. PIPE WITH 3.25" ALUM. CAP LS 7242

(SC) FOUND 2.5" ALUM. PIPE WITH 3.25" ALUM. CAP LS 7242

(SC) FOUND 1.5" STEEL PIPE WITH 3" ALUM. CAP LS 4845

(CC) FOUND 1.5" STEEL PIPE WITH 3" ALUM. CAP, ILLEGIBLE
LAT: 40.34904°N
LONG: 104.35996°W

FOUND 2.5" PIPE WITH 3.25" ALUM. CAP LS 7242

N 89°03'28" E 2362.11'

S.6, T.4N., R.62W.

N 89°03'28" E 2592.32'

FOUND 2.5" ALUM. PIPE WITH 3.25" ALUM. CAP LS 7242

N 02°58'22" W 2803.60'
N 02°56'13" W 2602.93'

N 03°37'12" W 2791.85'
N 03°37'12" W 2600.40'

S 04°05'16" E 2769.67'
S 04°01'23" E 4366.30'
S 04°03'45" E 2597.69'

LAT: 40.33426°N
LONG: 104.37679°W

FOUND 2.5" ALUM. PIPE WITH 3.25" ALUM. CAP LS 7242

FOUND 2.5" PIPE WITH 3.25" ALUM. CAP LS 7242

FOUND 2.5" ALUM. PIPE WITH 3.25" ALUM. CAP LS 7242

LAT: 40.33433°N
LONG: 104.35884°W

LEGEND

- = ALIQUOT MONUMENT AS DESCRIBED
- = CALCULATED POSITION
- = SURFACE HOLE LOCATION (SHL)
- ▲ = ENTRY POINT LOCATION (EP)
- = BOTTOM HOLE LOCATION (BHL)
- ⊕ = EXISTING WELL
- ⊙ = ABANDONED WELL

CLIENT: BONANZA CREEK ENERGY				LANDMAN: STEVE MCPHERSON					
INSTRUMENT OPERATOR: ADAM BEAUPREZ				SURVEY DATE: 11/17/2014		SURFACE USE: RANGELAND			
SHL FOOTAGE	SHL LAT°	SHL LONG°	SHL PDOP	SHL ELEV	SHL 1/4/1/4	SHL S-T-R			
390	FNL	698	FEL	40.34798	-104.36238	1.7	4544	NENE	6-4-62

BHL FOOTAGE	BHL LAT°	BHL LONG°	BHL S-T-R	EP LAT°	EP LONG°	EP S-T-R			
470	FSL	186	FEL	40.33562	-104.35960	6-4-62	40.34758	-104.36050	6-4-62

NOTE:
1) Bearings shown are Grid Bearings of the Colorado State Plane Coordinate System, North Zone, North American Datum 1983. The lineal dimensions as contained herein are based upon the "U.S. Survey Foot."
2) Distances to section lines measured at 90 degrees from said section lines.
3) Ground elevations are based on an observed GPS elevation (NAVD 1988 DATUM).
4) Latitude and Longitude shown are (NAD 83 DATUM).
5) IMPROVEMENTS: See LOCATION DRAWING for all visible improvements within 500' of disturbed area.
6) This map does not represent a boundary survey.

NEAREST CULTURAL ITEMS	
BUILDING	+5280'
BUILDING UNIT	+5280'
HIGH OCCUPANCY BUILDING UNIT	+5280'
DESIGNATED OUTSIDE ACTIVITY AREA	+5280'
PUBLIC ROAD	+5280'
ABOVE GROUND UTILITY	±2586' SW
RAILROAD	+5280'
PROPERTY LINE	±390' N



Kyle E. Rutz - On Behalf of Lat40, Inc.
Colorado Licensed Professional Land Surveyor No. 38307
DATE: 12/3/2014
PROJECT#: 2014214