


KERR-MCGEE OIL AND GAS ONSHORE LP
DEVON 38-8
SE SE 8 3N 66W 716' FSL 622' FEL
WELD,COLORADO
02/25/2015

AREA: N1 ROUTE: N14 Spud: 06/29/2007 WINS No.: 92797 AFE/WO#: 88611282 API#: 0512324257

GL: 4890 KB: 4902 MTD: 8109 TVD: 8007 LOG MD: 1700 PBMD: 8065 PBTVD: 7963

Directions: WCR 34 & WCR 29, N 1/8, W INTO

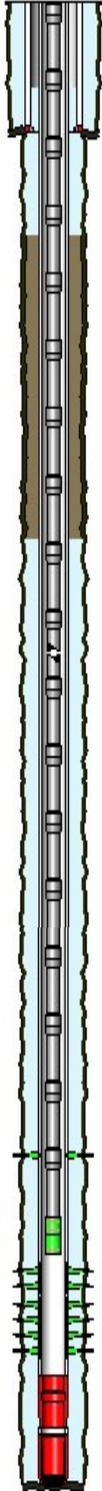

<u>HOLE SECTIONS</u>		<u>Size</u>	<u>Top</u>	<u>Btm</u>	<u>TD Date</u>				
SURFACE		12.25	12	870	06/30/2007				
PRODUCTION		7.88	860	8109	07/04/2007				
<u>TUBULARS</u>		<u>Tool Type</u>	<u>Joints</u>	<u>Size</u>	<u>Weight</u>	<u>Grade</u>	<u>Thread</u>	<u>Top D</u>	<u>Bottom D</u>
SURFACE CASING									
	Casing	20	8.63	24.00	J-55	STC	12	859	
	Casing Guide Shoe	1	8.63				859	860	
PRODUCTION CASING									
	Casing	192	4.50	11.60	I-80	LTC	12	8063	
	Float Collar	1	4.50				8063	8063	
	Casing	1	4.50	11.60	I-80	LTC	8063	8092	
	Casing Shoe	1	4.50				8092	8094	
PRODUCTION TUBING									
	Tubing	251	2.38	4.70	J-55	External-Ups	12	7904	
	XN Profile Nipple	1	2.38				7904	7905	
	Notched Collar	1	2.38				7905	7905	
<u>CEMENT JOBS</u>		<u>Stage</u>	<u>Sacks</u>	<u>Cement Jobs</u>		<u>Top D</u>	<u>Btm D</u>	<u>cbl</u>	
SURFACE CASING									
	PRIMARY	590		DJ - PREMIUM		12	859	No	
PRODUCTION CASING									
	PRIM CMT 1ST STAGE	280	CHECK 1	PREM. LITE CEMENT		3510	5300	Yes	
	PRIM CMT 2ND STAGE	110	CHECK 1	PREM LITE CEMENT		5300	6800	Yes	
	PRIM CMT 3RD STAGE	215	CHECK 1	DJ - 50/50 POZ-MIX		6800	8094	Yes	
PRODUCTION CASING									
	ONE INCH JOB	185	LEAD	CEMENT		598	1529	Yes	
<u>PERFORATIONS</u>									
<u>Formation</u>	<u>Zone</u>	<u>Top</u>	<u>Btm</u>	<u>Date</u>	<u>Reason</u>	<u>Comments</u>			
CODELL		7500	7516	07/16/2007	PRODUCTION	4 SPF			
J SAND	J-Sand	7952	7954	04/27/2010	PRODUCTION				
J SAND	J-Sand	7972	7980	04/27/2010	PRODUCTION				
J SAND	J-Sand	7984	8004	04/27/2010	PRODUCTION				

Comments: