

KERR-MCGEE OIL AND GAS ONSHORE LP

STRONG P 21-10 J

NW SE 21 3N 67W 1,900' FSL --

WELD,COLORADO

02/26/2015

AREA: N2

ROUTE: N21

Spud: 04/24/1989

WINS No.: 88039

AFE/WO#: 2101480

API#: 0512314265

GL: 4792

KB: 4792

MTD: 8837

TVD: 8837


LOG MD: 6800

PBMD: 8820

PBTVD: 7570

Directions:

HWY 66 & CR 19 W 4/10, N 3/10, E INTO. SMALL DITCH 5' NORTH OF WELLHEAD.

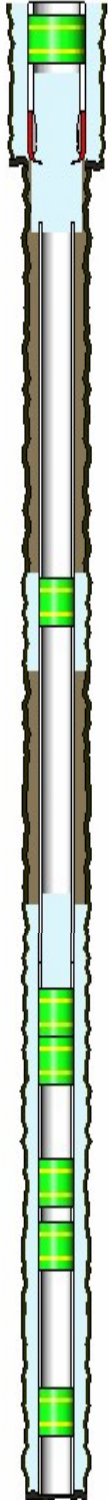

<u>HOLE SECTIONS</u>	<u>Size</u>	<u>Top</u>	<u>Btm</u>	<u>TD Date</u>
SURFACE	12.25	11	486	
PRODUCTION	7.88	486	8880	

<u>TUBULARS</u>	<u>Tool Type</u>	<u>Joints</u>	<u>Size</u>	<u>Weight</u>	<u>Grade</u>	<u>Thread</u>	<u>Top D</u>	<u>Bottom D</u>
SURFACE CASING	Casing	11	8.63	24.00			11	484
	Casing Guide Shoe	1	8.63				484	486
BRIDGE PLUG	Cast Iron Bridge Plu		5.50				8520	8521
BRIDGE PLUG	Cast Iron Bridge Plu		5.50				7570	7571
BRIDGE PLUG	Cast Iron Bridge Plu	1	5.50				6840	6841
BRIDGE PLUG	CIBP With CMT Cap	1	5.50				7440	7441
BRIDGE PLUG	Cast Iron Bridge Plu	1	5.50				6839	6840
Cement Retainer	Cement Retainer	1	5.50				3882	3883
PRODUCTION CASING	Casing	132	5.50	15.50			970	6626
	Casing	56	5.50	17.00			6626	8871
BRIDGE PLUG	Cast Iron Bridge Plu	1	8.63				80	82

<u>CEMENT JOBS</u>	<u>Stage</u>	<u>Sacks</u>	<u>Cement Jobs</u>	<u>Top D</u>	<u>Btm D</u>	<u>cbl</u>
SURFACE CASING		235	Surface Ce	11	486	No
		675	LEAD	6150	8871	No
PRODUCTION CASING	ABANDONMENT PLUC	75	LEAD CEMENT	6056	6825	No
PRODUCTION CASING	SQUEEZE JOB	220	LEAD CEMENT	3840	4250	No
SURFACE CASING	ABANDONMENT PLUC	400	LEAD CEMENT	310	1056	No

<u>PERFORATIONS</u>	<u>Formation</u>	<u>Zone</u>	<u>Top</u>	<u>Btm</u>	<u>Date</u>	<u>Reason</u>	<u>Comments</u>
	SUSSEX		3840	3841	01/29/2015	CEMENT SQUEEZE	Perforate 3 Shots / Ft From 384
	SUSSEX		4250	4251	01/29/2015	CEMENT SQUEEZE	Perforated 3 Shots / Ft From 42
	NIOBRARA		6905	6906	11/03/1992	PRODUCTION	
	CODELL		7104	7118	03/21/2003	PRODUCTION	CODELL REFRAC
	CODELL		7110	7122	11/03/1992	PRODUCTION	-
	J SAND		7501	7505	05/30/1989	PRODUCTION	
	J SAND		7513	7539	05/30/1989	PRODUCTION	
	LYONS		8716	8722	05/30/1989	PRODUCTION	NONPRODUCTIVE
	LYONS		8750	8774	05/30/1989	PRODUCTION	NONPRODUCTIVE

Comments: