

KERR-MCGEE OIL AND GAS ONSHORE LP

**DRY CREEK 1
NW SW 23 1S 68W -- --
ADAMS,COLORADO
03/05/2015**

AREA: W3

ROUTE: W35 Spud: 11/13/1990

WINS No.: 74587

AFE/WO#: 2081149

API#: 0500108982

GL: 5135

KB: 5146

MTD: 8790


TVD: 8790

LOG MD: 8810

PBMD: 8767

PBTVD: 8767

Directions: HWY 7 & WASHINGTON, S TO 136 AVE, E 1/10 TO DOWNING ST., N 2/10, W INTO.

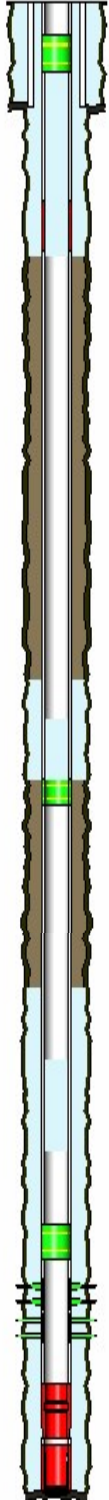

| <u>HOLE SECTIONS</u> | <u>Size</u> | <u>Top</u> | <u>Btm</u> | <u>TD Date</u> |
|----------------------|-------------|------------|------------|----------------|
| SURFACE | 12.25 | 11 | 470 | 11/13/1990 |
| PRODUCTION | 7.88 | 468 | 8810 | 11/23/1990 |

| <u>TUBULARS</u> | <u>Tool Type</u> | <u>Joints</u> | <u>Size</u> | <u>Weight</u> | <u>Grade</u> | <u>Thread</u> | <u>Top D</u> | <u>Bottom D</u> |
|-------------------|----------------------|---------------|-------------|---------------|--------------|---------------|--------------|-----------------|
| SURFACE CASING | Casing | 11 | 8.63 | 24 | J-55 | | 11 | 468 |
| PRODUCTION CASING | Casing | 29 | 4.50 | 11.6 | M-75 | | 11 | 1180 |
| | Stage Collar | 1 | 4.50 | | | | 1180 | 1184 |
| | Casing | 97 | 4.50 | 11.6 | M-75 | | 1184 | 5206 |
| | Cement Stage Too | 1 | 4.50 | | | | 5206 | 5208 |
| | Casing | 87 | 4.50 | 11.6 | M-75 | | 5208 | 8767 |
| | Casing Float Collar | 1 | 4.50 | | | | 8767 | 8768 |
| | Casing | 1 | 4.50 | 11.6 | M-75 | | 8768 | 8802 |
| | Casing Guide Shoe | 1 | 4.50 | | | | 8802 | 8805 |
| BRIDGE PLUG | CIBP With CMT Cap | 1 | 4.50 | | | | 8400 | 8403 |
| BRIDGE PLUG | Cast Iron Bridge Plu | | 4.50 | | | | 200 | 202 |

| <u>CEMENT JOBS</u> | <u>Stage</u> | <u>Sacks</u> | <u>Cement Jobs</u> | <u>Top D</u> | <u>Btm D</u> | <u>cbl</u> |
|--------------------|--------------------|--------------|--------------------|--------------|--------------|------------|
| SURFACE CASING | PRIM CMT 1ST STAGE | 320 | LEAD NEAT | 11 | 468 | No |
| PRODUCTION CASING | PRIM CMT 2ND STAGE | 255 | LEAD CLASS G | 4450 | 5206 | Yes |
| | PRIM CMT 1ST STAGE | 50 | LEAD 50/50 POZ-MIX | 6600 | 6718 | Yes |
| | PRIM CMT 1ST STAGE | 435 | TAIL CLASS G | 6718 | 8810 | Yes |
| PRODUCTION CASING | TOP OUT JOB | 210 | LEAD PC LITE | 11 | 718 | Yes |
| | TOP OUT JOB | 165 | TAIL CLASS G | 718 | 1218 | Yes |
| PRODUCTION CASING | ABANDONMENT PLUC | 40 | LEAD CEMENT | 7152 | 7848 | No |
| PRODUCTION CASING | ABANDONMENT PLUC | 35 | LEAD-1 CEMENT | 4750 | 5200 | No |
| | ABANDONMENT PLUC | 65 | LEAD-2 CEMENT | 248 | 1220 | No |

| <u>PERFORATIONS</u> | <u>Formation</u> | <u>Zone</u> | <u>Top</u> | <u>Btm</u> | <u>Date</u> | <u>Reason</u> | <u>Comments</u> |
|---------------------|------------------|-------------|------------|------------|-------------|---------------|-----------------|
| | J SAND | | 8510 | 8514 | 12/13/1990 | PRODUCTION | |
| | J SAND | | 8534 | 8541 | 12/13/1990 | PRODUCTION | |

Comments: