


Noble Energy, INC  
Pfeiffer #16-26  
05-123-13396

**Current Wellbore Schematic**

Status - DA  
KB elev - 4633'  
GL elev - 4623'

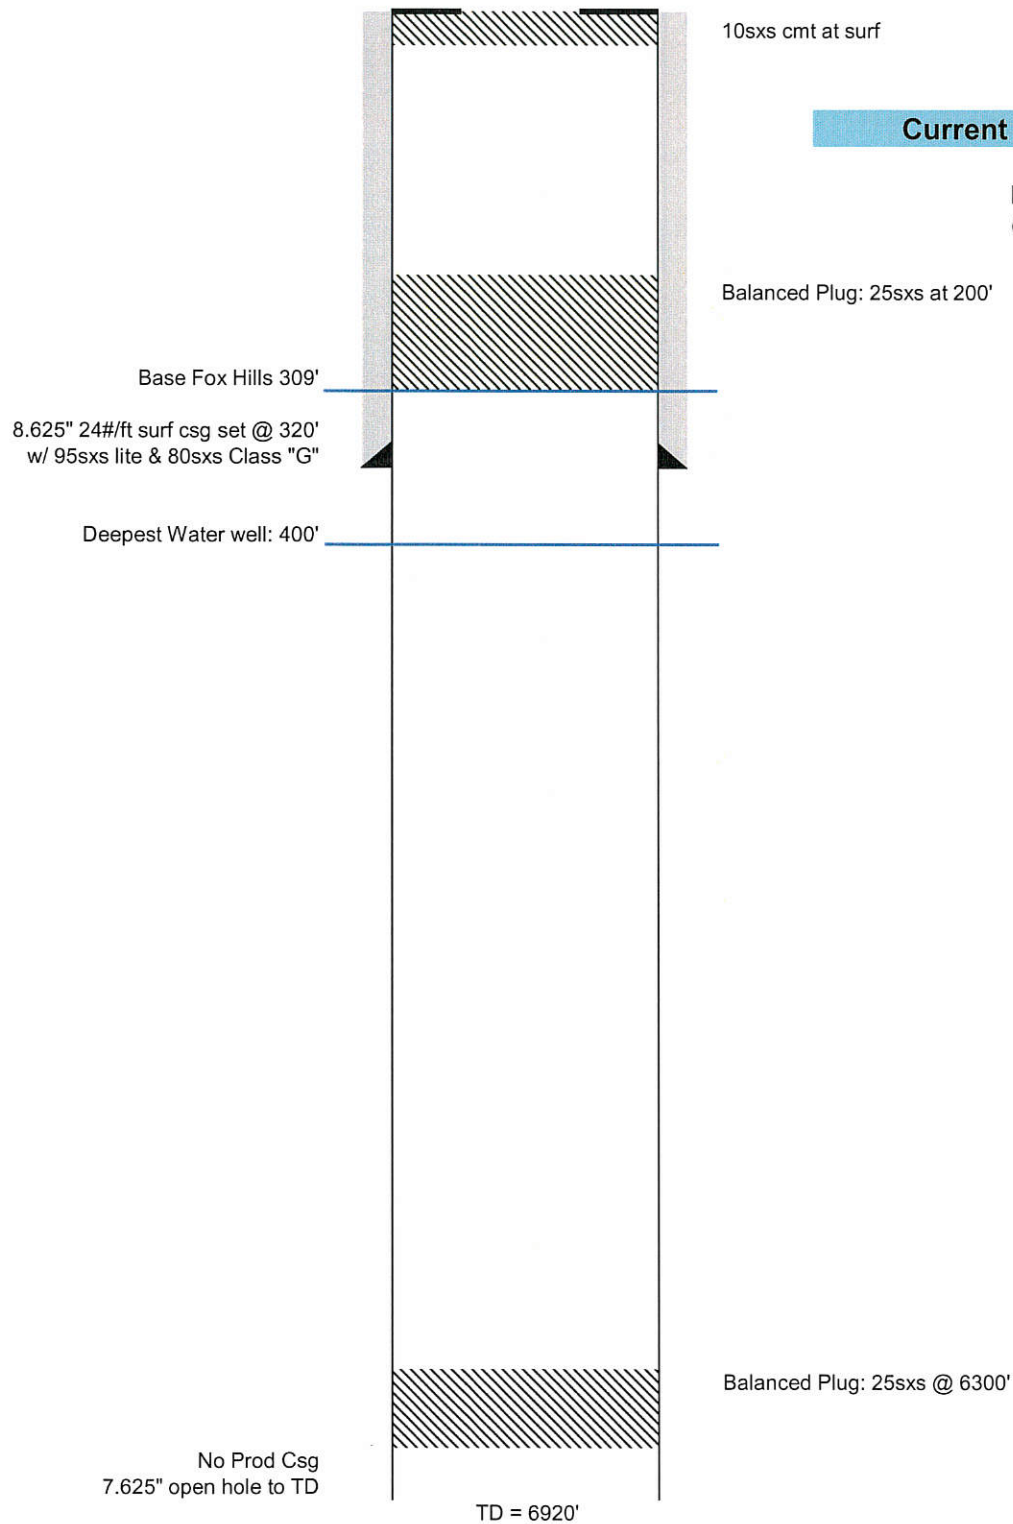

Hunter Dunham  
3/4/2015