



August 6, 2014

Mr. Matt Lepore, Director  
Colorado Oil and Gas Conservation Commission  
1120 Lincoln Street  
Suite 801  
Denver, Colorado 80203

**RE: COGCC Rule 318A.e.: Proposed Wellbore Spacing Unit  
Waag #25  
SESW Section 19, Township 7 North, Range 65 West  
Weld County, Colorado**

Dear Mr. Lepore:

Extraction Oil & Gas is planning to drill the above referenced well in accordance with the provisions set out in COGCC Rule 318A.e. Extraction's proposed wellbore spacing unit consists of:

Waag #25  
S/2SW/4 of Sec 19 7N-65W; N/2NW/4 of Sec. 30 7N-65W;  
S/2SE/4 of Sec 24 7N-66W; N/2NE/4 of Sec 25 7N-66W 320 acres more or less.

Extraction is not the only owner within the proposed wellbore spacing unit and has provided notice to the remaining owner(s) within this spacing unit, as required by COGCC Rule 318A.e.(6). Copies of the required notification letters are on file at Extraction's office. The required thirty (30) day notice period has elapsed absent the receipt by Extraction of any objection to their proposal by the owner(s) within the proposed spacing unit for the subject well.


Enclosed is the Proposed Spacing Unit Plat to assist in your review and approval of Extraction's proposed Application for Permit to Drill (APD) for the Waag #25 well. Extraction respectfully requests the COGCC review the enclosed information and approve the requested exception location waiver and APD for the Waag #25.

Respectfully,

Nick Curran  
Regulatory Tech  
Agent for Extraction Oil & Gas

Attachment: Proposed Spacing Unit Plat

100% Extraction  
Leasehold

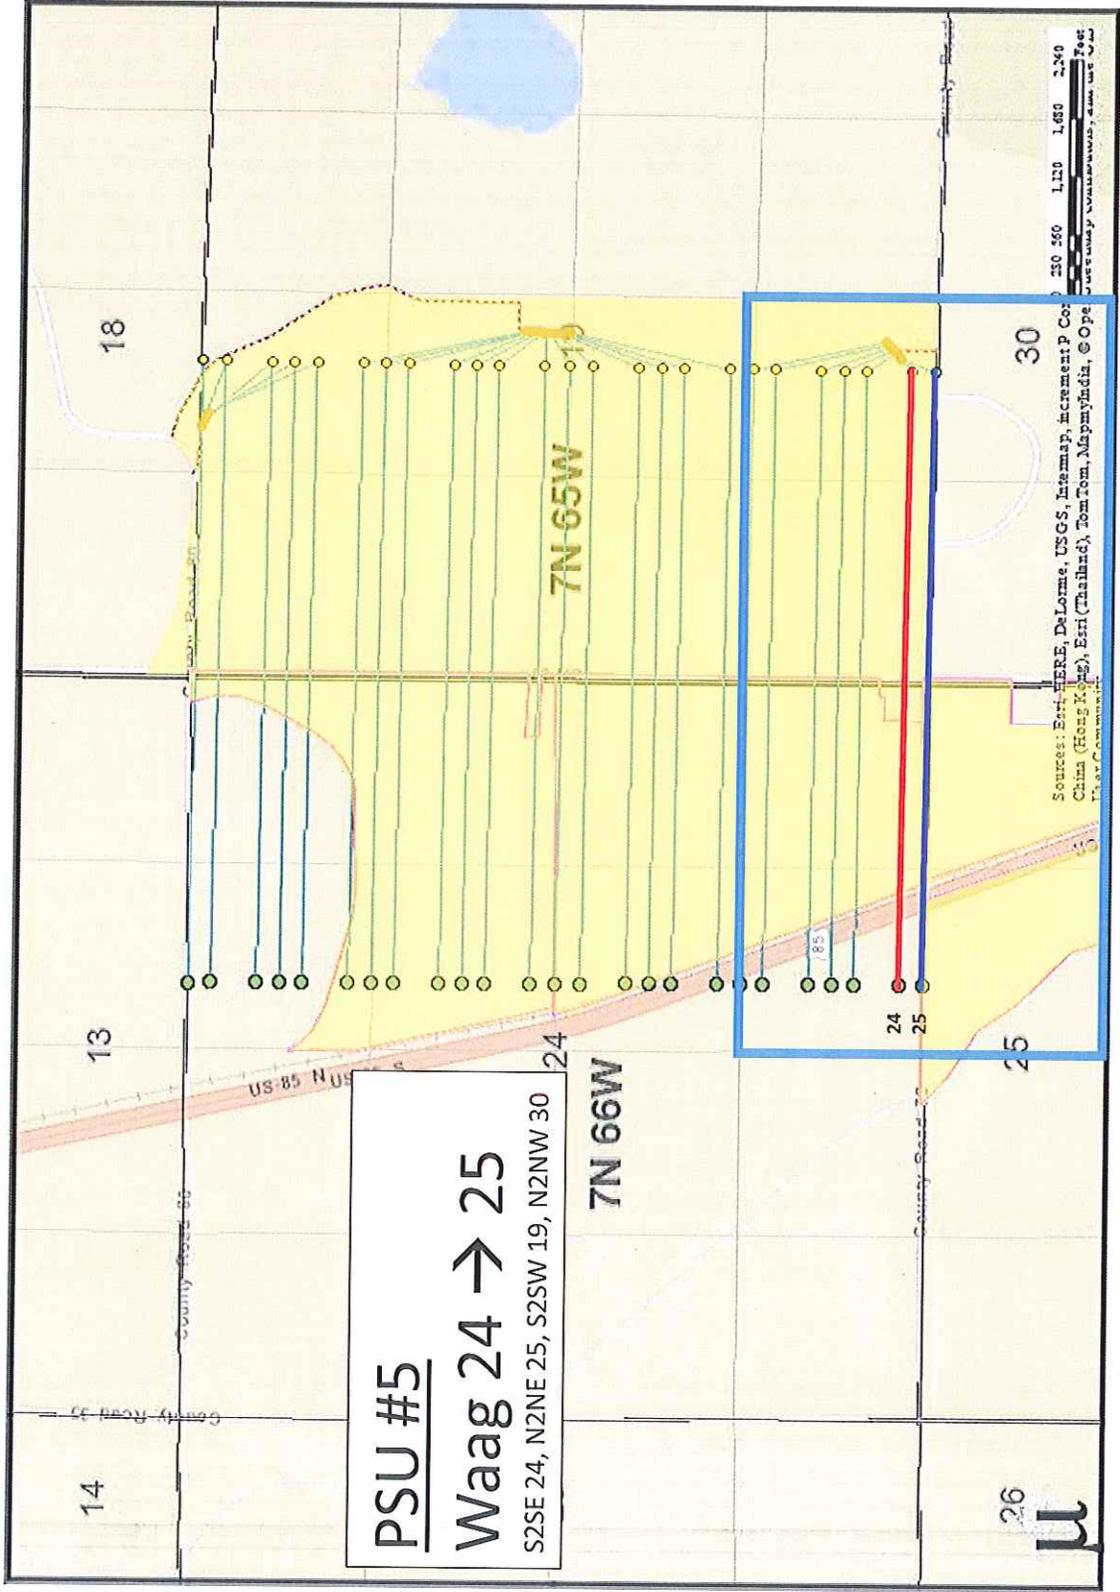

**PSU #5**  
**Waag 24 → 25**  
S2SE 24, N2NE 25, S2SW 19, N2NW 30