



Owner: Maggie Operating Inc Well Name: LBSU S3  
County: Washington Field: Little Beaver Pool: D sand Unit  
Coordinates: Sec: SENE6 Twp: 2 S Rng 56W

Bore Diameters (in.)

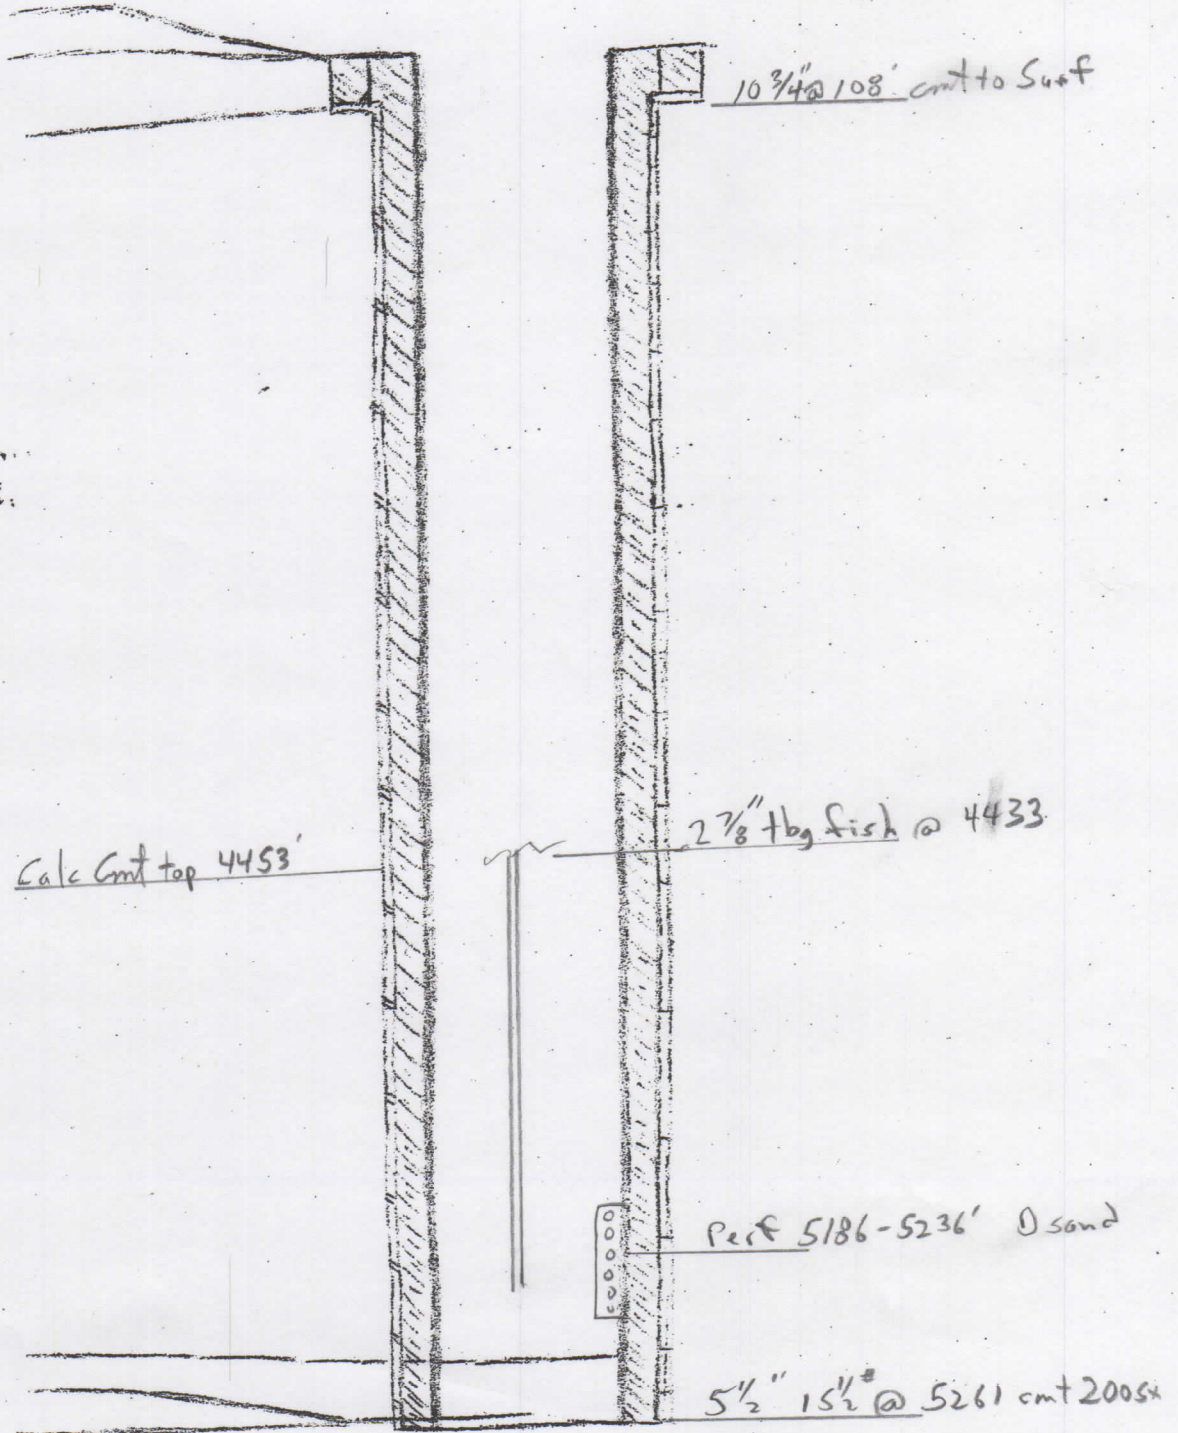

Owner: Maggie Operating Inc	Well Name: LBSU S3
County: Washington	Pool: D sand Unit
Coordinates:	Sec: SENE6 Twp: 2 S R: 56
	Field: Little Beaver

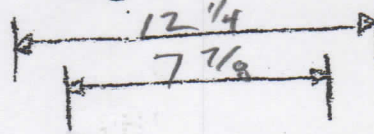