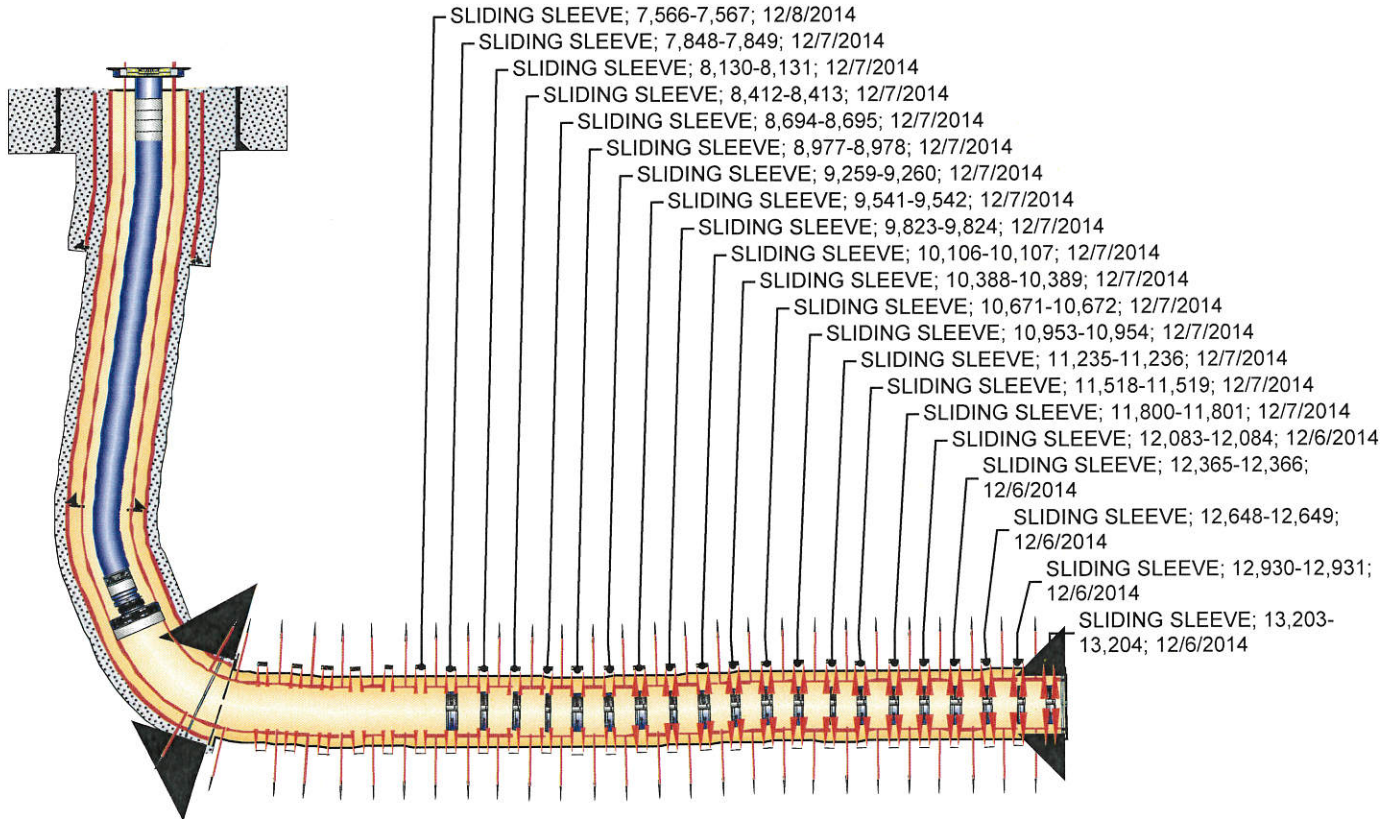


Well Name: Ohare 1-29-11-57

API/UWI 05-123-40081	Field Name NIOBRARA SHALE	County WELD	State/Province COLORADO	State Plane (E/W - X) (ft) 3,477,193	State Plane (N/S - Y) (ft) 1,572,396
Spud Date 9/16/2014 10:30	Date TD Reached 9/26/2014 04:00	Rig Release Date 9/28/2014 10:00	Original KB Elevation (ft) 4,944	Ground Elevation (ft) 4,927	Total Depth (All) (ftKB)

HORIZONTAL - ORIGINAL HOLE, 3/13/2015 9:31:26 AM
Directional schematic (actual)


Csg Des	Set Depth (ftKB)	OD (in)	Wt (lb/ft)	Grade	Top Thread
PRODUCTION	13,345	5	11.60	P-110	LT&C