


**WELLBORE DIAGRAM**  
**High Plains Disposal, Inc.**  
**HPD Platteville 2**  
NESE Sec 24-T3N-R66W  
SHL: 2311' FSL & 242' FEL  
Weld County, CO  
API# 05-123-39710

**CURRENT**

2/7/2015  
PAG



K.B.= 5016 Estimated  
G.L.= 4998  
18

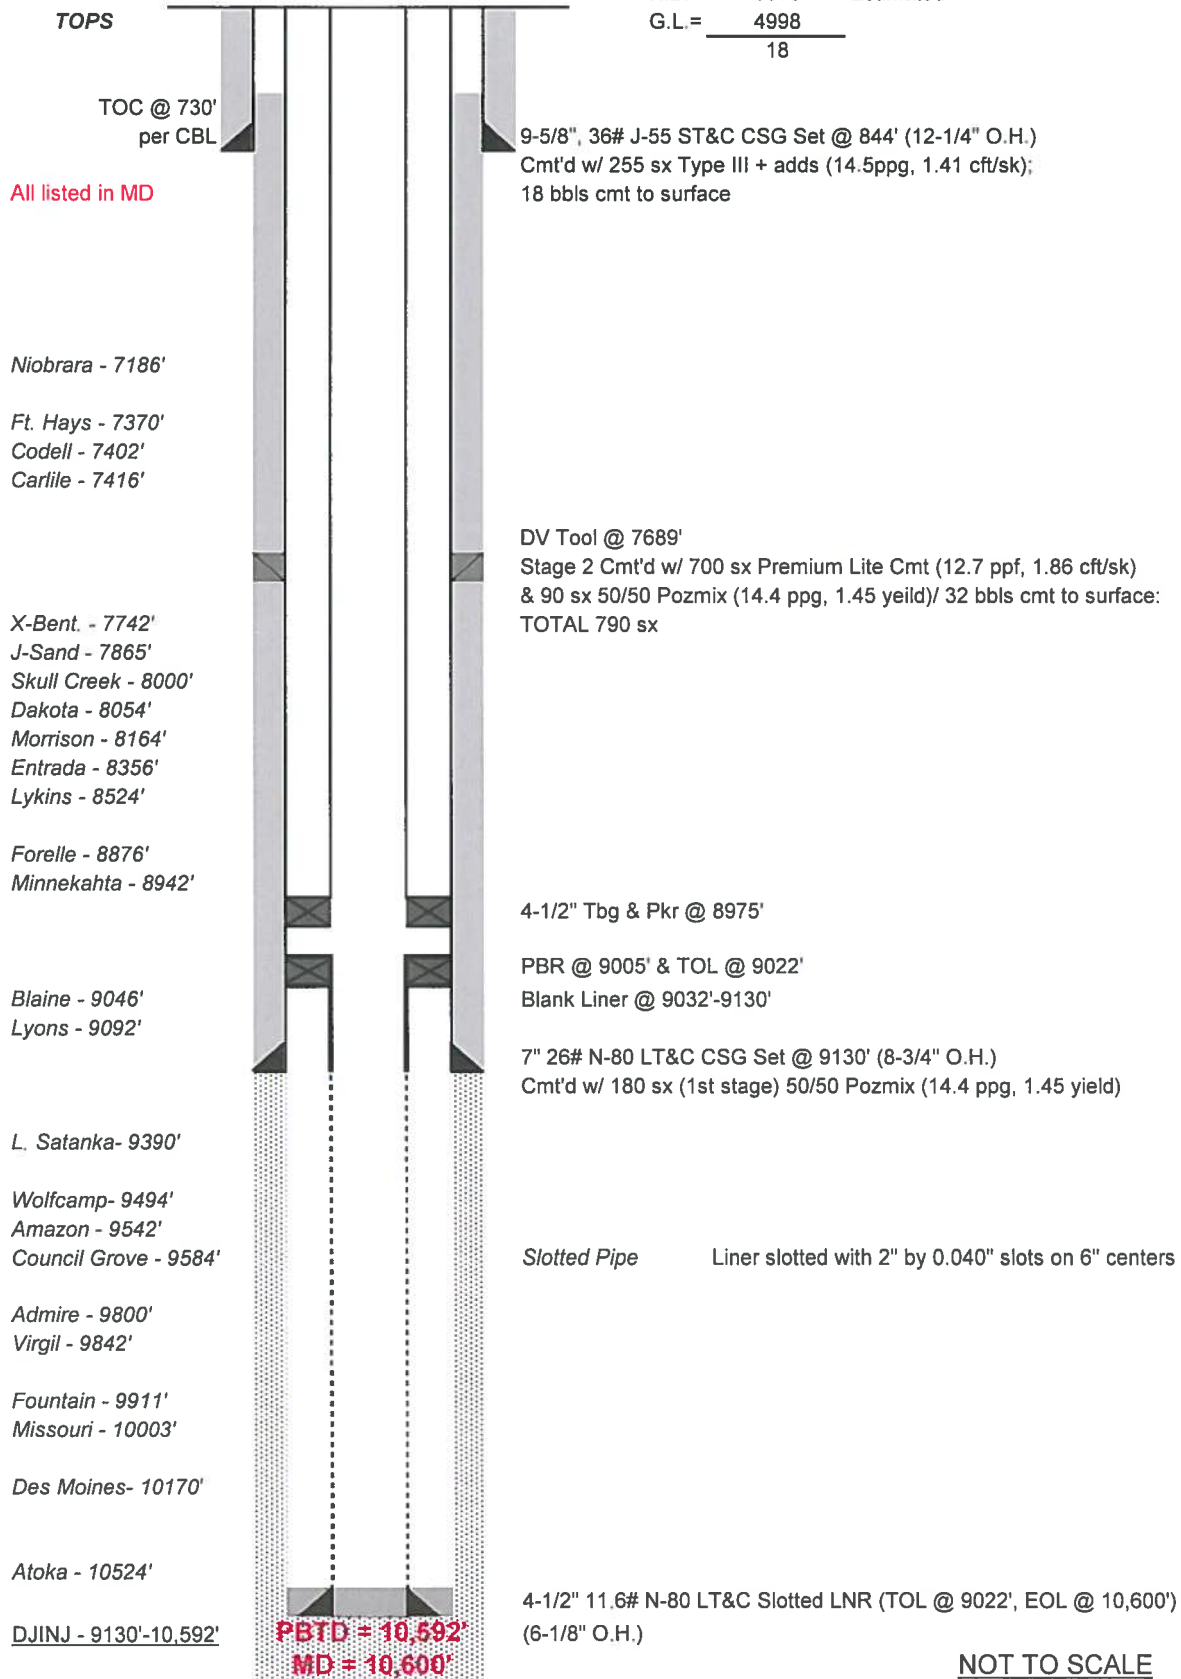

**NOT TO SCALE**