



**Lease Name:** Wirth #1


**Legals:** NENE – Sec. 1 6N 59W

**County:** Morgan County, Colorado

**API#:** 05-087-06719

**Spud Date:** 10/27/1965

**P & A Date:** 2/5/1981

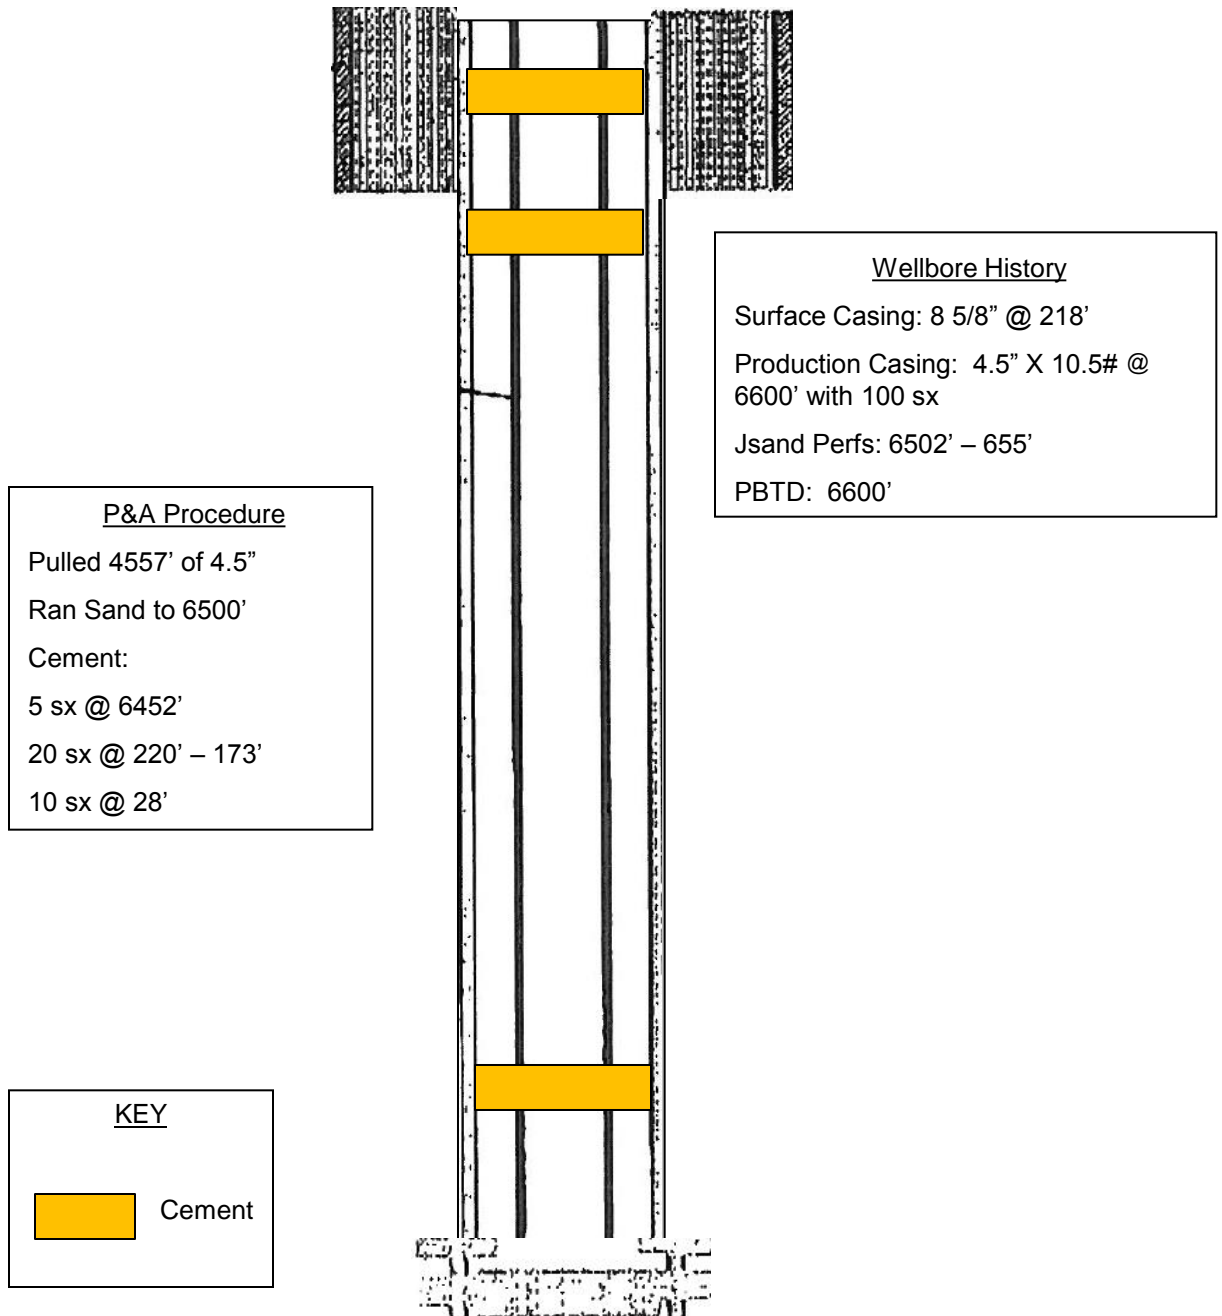

**Plugged Wellbore Diagram**