

GREAT WESTERN OIL & GAS COMPANY
Well Name: Clyde Williams Jr #2
SENE 34 2S 64W
Adams County, CO
FINAL P&A WELLBORE SCHEMATIC (3/25/2015)

API: 05-001-07733

GL Elev: 5378
KB Elev:

Spud Date: 11/11/1980
Completion Date: 5/8/1981


Cut and capped 4' below ground level

Surface Casing :

8-5/8" 24# set @ 210' KB
Cmt w/ 250 sx
12-1/4" Hole

Prod Interval:

5-1/2" 15.5# & 17# set @ 8100' KB
CMT w/ 200 sx
7-7/8" Hole

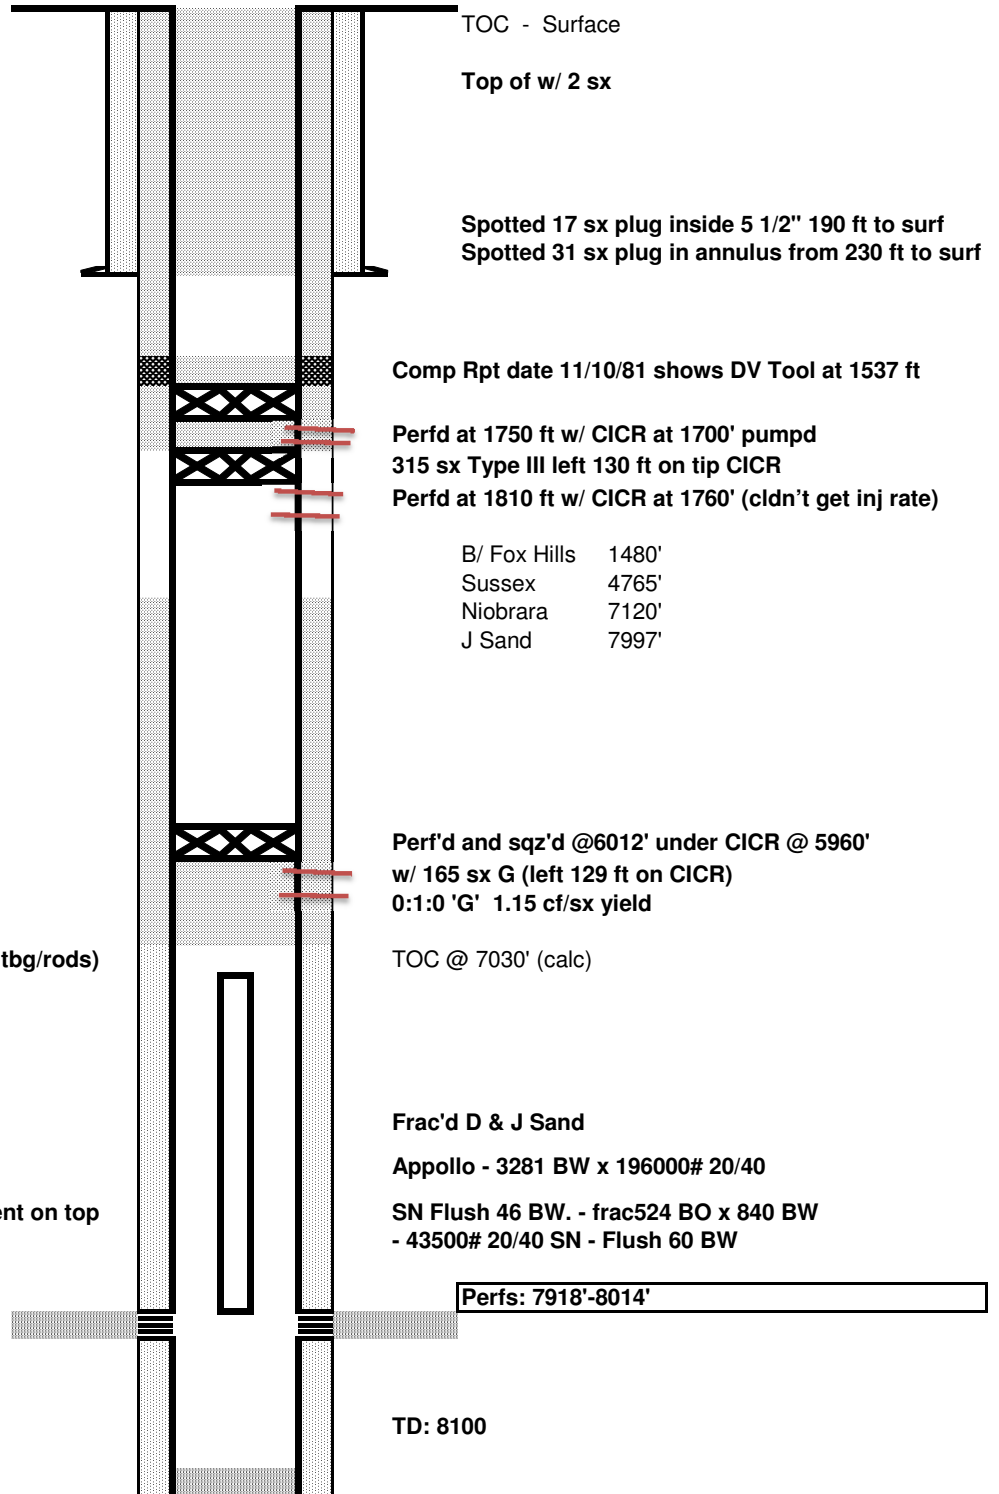

CIBP @ 7,310 w/ 2 sx cement on top