


Well Name: MOTIS 01 API 05732

VERTICAL - Original Hole, 3/25/2015 12:56:26 PM

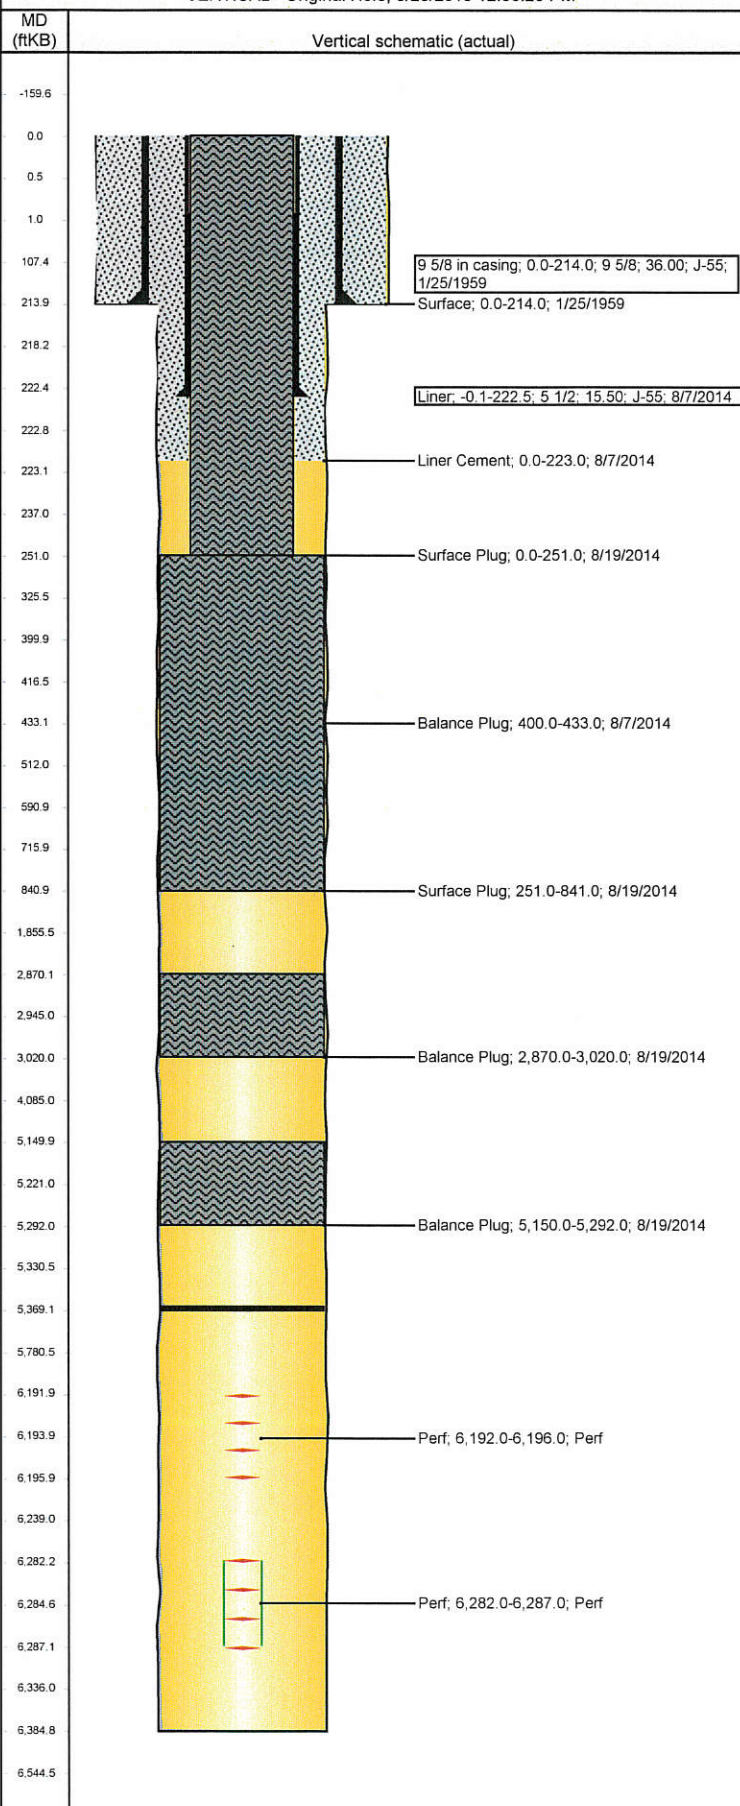

Well Header

API	Business Unit	District	Well Config
05-123-05732	DJ BASIN	15	VERTICAL
Original KB Elevation (ft)	KB - GL / MSL (ftKB)	Spud Date	P & A Date
		12/8/1964	
Comment			

Directions To Well

WCR 127 & WCR 116, EAST 3.2 mi, SOUTH 3.0 mi, NORTHWEST INTO.

Current PBTD (ftKB)

Original Hole - 5,369.0

Bottom Hole Location

North-South Distance (ft)	From N or S Line	East-West Distance (ft)	From E or W Line

Plug Back Total Depths

Date	Depth (ftKB)	Method	Com
8/15/2014	5,369.0	TUBING TALLY	

Wellbore Sections

Section Des	Size (in)	Act Top, MD (ftKB)	Act Btm, MD (ftKB)
SURFACE	13 3/4	0.0	214.0
PRODUCTION	7 7/8	214.0	6,385.0

Zone Statuses

Zone Name	Status Date	Status	Fluid Type	Job

Casing Strings

Csg Des	Run Date	OD (in)	Wt/Len (lb/ft)	Grade	Top, MD (ftKB)	MD (ftKB)
9 5/8 in casing	1/25/1959	9 5/8	36.00	J-55	0.0	214.0
Liner	8/7/2014	5 1/2	15.50	J-55	-0.1	222.5

Cement

Des	Top (ftKB)	Btm (ftKB)
Surface	0.0	214.0
Balance Plug	400.0	433.0
Liner Cement	0.0	223.0
Surface Plug	0.0	251.0
Surface Plug	251.0	841.0
Balance Plug	2,870.0	3,020.0
Balance Plug	5,150.0	5,292.0

Tubing Components

Item Des	OD (in)	Wt (lb/ft)	Grade	Jts	Len (ft)

Perforation Data

Zone	Bnch/St g	Entered Shot Total	Top (ftKB)	Btm (ftKB)	Date
			6,192.00	6,196.00	
			6,282.00	6,287.00	

Stimulations & Treatments

Bnch/Stg	Date	Zone	Primary Job Type
Comment			
Total Add Amount	Total Clean Volume...	Vol Slurry Tot (gal)	Vol Gas Tot (MCF)
	199.92		
Avg Treat Pressure (psi)	Max Treat Pressure (psi)	Avg Treat Rate (bbl/min)	Max Treat Rate (bbl/min)

Other In Hole

Run Date	Des	OD (in)	Top (ftKB)	Btm (ftKB)

Logs

Date	Type	Top, MD (ftKB)	Btm, MD (ftKB)