



1625 Broadway  
Suite 2000  
Denver, CO 80202

Tel: 303.228.4000  
Fax: 303.228.4280  
www.nobleenergyinc.com

March 5, 2015

Colorado Oil and Gas Conservation Commission  
The Chancery Building  
1120 Lincoln Street, Suite 801  
Denver, CO 80203  
Attn: Mr. Matt Lepore, Director

RE: Wells Ranch State A36-655  
Section 31: NE/4SE/4 Township 6 North, Range 63 West, 6th P.M.  
Weld County, Colorado

Dear Director:

Noble Energy, Inc. ("NEI") is planning to drill the captioned boundary well in accordance with the provisions of COGCC Rule 318A.e.

NEI's proposed wellbore spacing unit consists of the S/2N/2, N/2S/2 Sec. 31 T6N R63W, S/2N/2, N/2S/2 Sec. 36, SE/4NE/4 NE/4SE/4 Sec. 35, T6N, R64W, creating a 714-acre wellbore spacing unit for the Niobrara formation. NEI is the only owner within the proposed wellbore spacing unit, therefore NEI hereby attests that no notice letters are required under COGCC Rule 318Ae.(5).

Enclosed are copies of the following documents to assist you in your review and approval of NEI's proposed APD for the captioned well:

- Map & plat illustrating proposed wellbore spacing unit.

Thank you for your attention to the enclosed. NEI respectfully requests that the COGCC review the enclosed information and approve the Application for Permit to Drill the captioned well.

Sincerely,

*Jan Kajiwar*

Jan Kajiwar  
Regulatory Analyst III  
Noble Energy Inc.


# Wells Ranch State A36-655

Proposed Spacing Unit – Noble Energy, Inc

S/2N/2, N/2S/2 Section 31, Township 6 North, Range 63 West

S/2N/2, N/2S/2 Section 36, Township 6 North, Range 64 West

SE/4NE/4, NE/4SE/4 Section 35, Township 6 North, Range 64 West

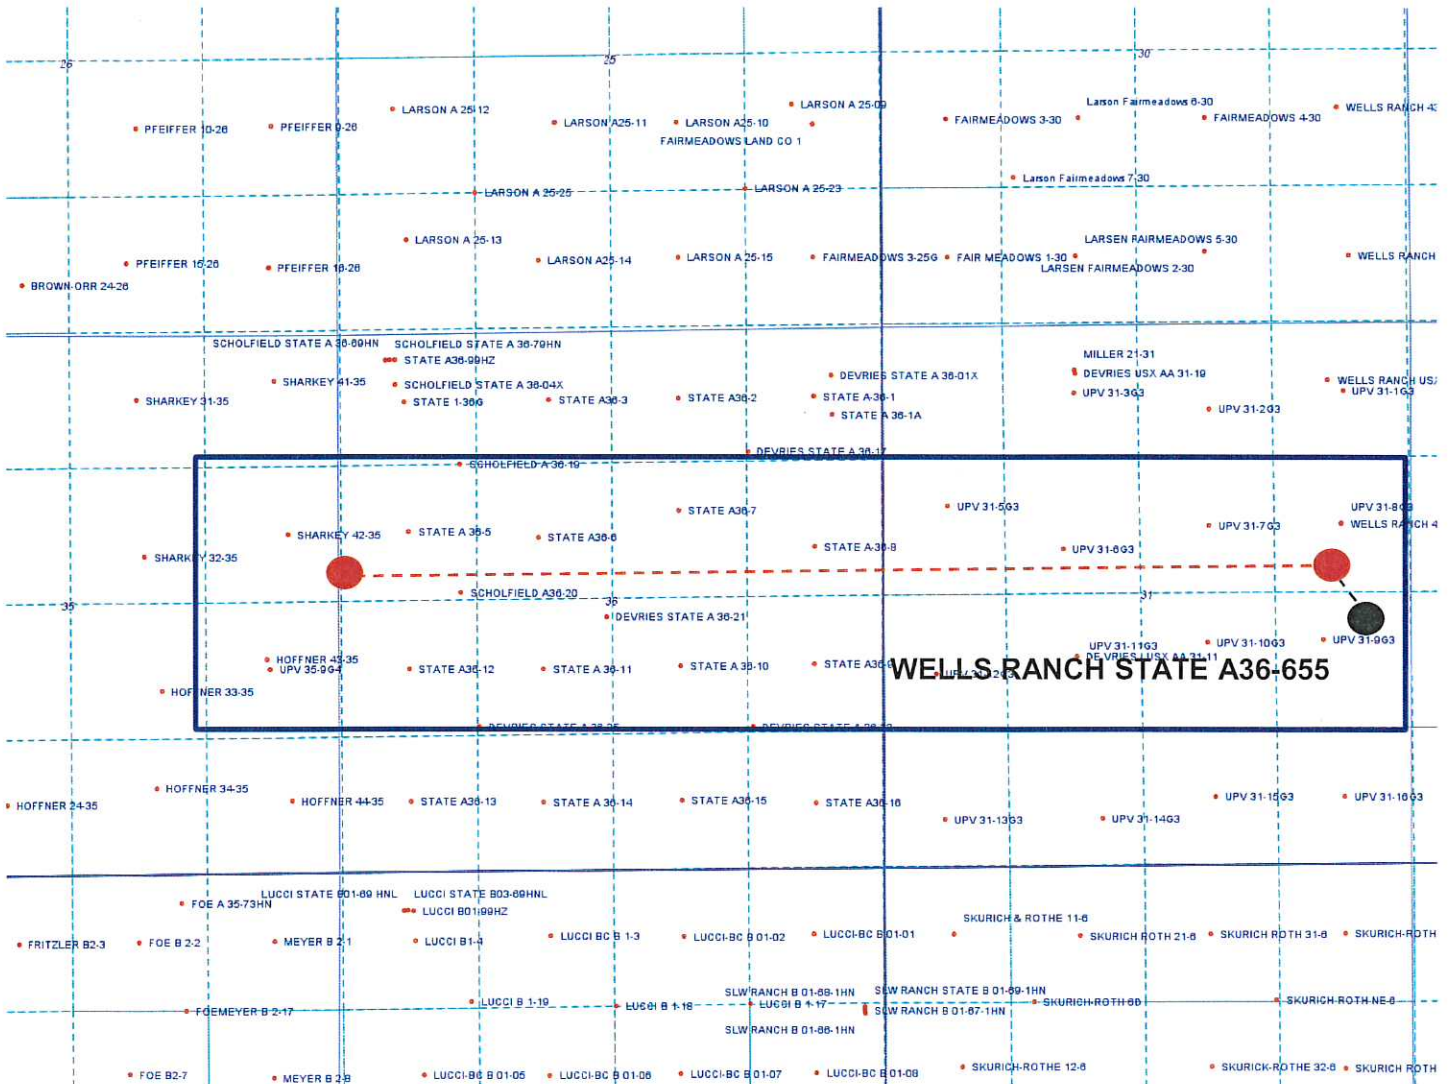

## Legend



Proposed 713.36± acre spacing unit



Bottom Hole Location




Lat40°, Inc. 6250 W. 10th Street, Unit 2, Greeley, CO 970-515-5294

# WELL LOCATION CERTIFICATE

WELLS RANCH STATE A36-655

SECTION: 31  
TOWNSHIP: 6N  
RANGE: 63W  
6TH. P.M.  
WELD COUNTY, CO

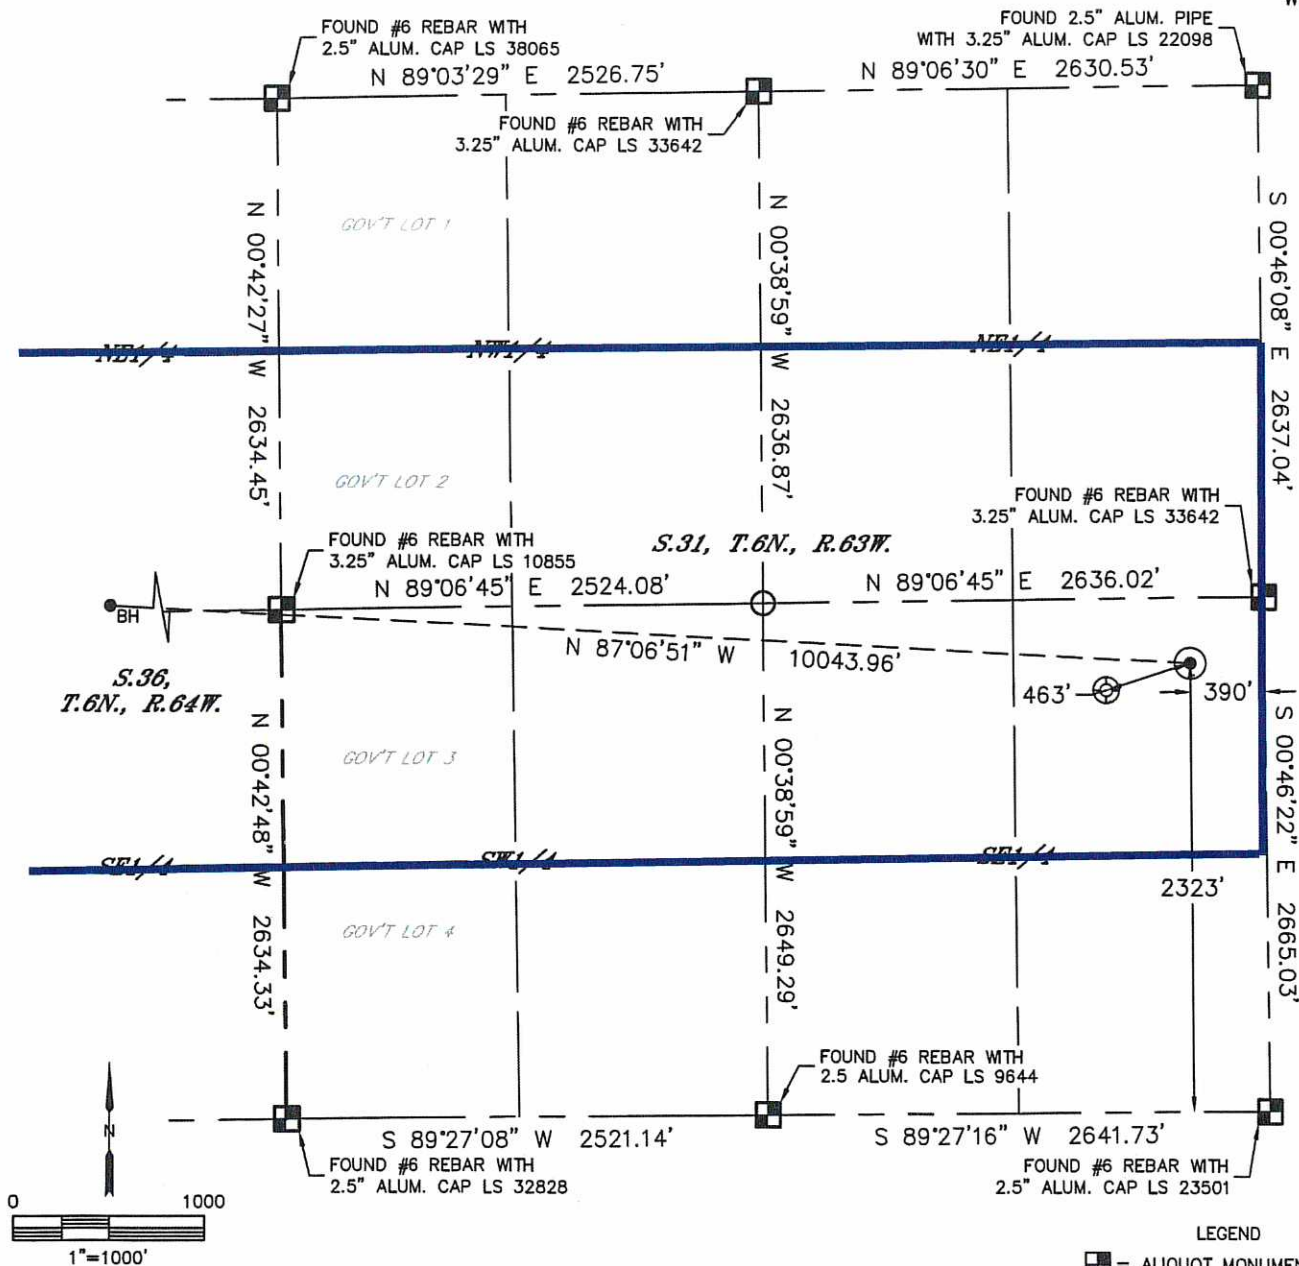

CLIENT: NOBLE ENERGY INC.			LANDMAN: GREG WILSON				
INSTRUMENT OPERATOR: ADAM BEAUPREZ			SURVEY DATE: 10/9/2014		SURFACE USE: RANGELAND		
SHL FOOTAGE	SHL LAT °	SHL LONG °	SHL PDOP	SHL ELEV (FT.)	SHL 1/4/1/4	SHL S-T-R	
2323 FSL 390 FEL	40.44210	-104.47162	2.0	4656	NESE	31-6-63	


BHL FOOTAGE	BHL LAT °	BHL LONG °	BHL S-T-R
2310 FNL 50 FWL	40.44380	-104.50763	36-6-64

NEAREST CULTURAL ITEMS	
EXISTING UPV 31-9G3	±463' SW
BUILDING	±3076' NW
BUILDING UNIT	±3161' NW
HIGH OCCUPANCY BUILDING UNIT	5280'+
DESIGNATED OUTSIDE ACTIVITY AREA	5280'+
PUBLIC ROAD (COUNTY ROAD 64)	±2962' N
ABOVE GROUND UTILITY	±2950' N
RAILROAD	5280'+
PROPERTY LINE	±390' E

## NOTE:

- 1) Bearings shown are Grid Bearings of the Colorado State Plane Coordinate System, North Zone, North American Datum 1983. The lineal dimensions as contained herein are based upon the "U.S. Survey Foot."
- 2) Distances to section lines measured at 90 degrees from said section lines.
- 3) Ground elevations are based on an observed GPS elevation (NAVD 1988 DATUM).
- 4) Latitude and Longitude shown are (NAD 83 DATUM).
- 5) IMPROVEMENTS: See LOCATION DRAWING for all visible improvements within 500' of disturbed area.
- 6) This map does not represent a boundary survey.

- LEGEND
- = ALIQUOT MONUMENT AS DESCRIBED
  - = CALCULATED POSITION
  - = SURFACE HOLE LOCATION (SHL)
  - ▲ = ENTRY POINT LOCATION (EP)
  - <sub>BH</sub> = BOTTOM HOLE LOCATION (BHL)
  - ⊗ = EXISTING WELL
  - ⊗<sub>A</sub> = ABANDONED WELL

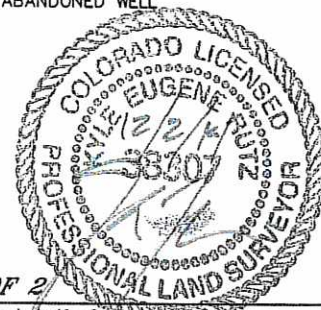

SHEET 1 OF 2

Kyle E. Rutz—On behalf of Lat40, Inc.  
Colorado Licensed Professional Land Surveyor No. 38307  
DATE: 12/2/2014  
PROJECT#: 2014164






Lat40°, Inc. 6250 W. 10th Street, Unit 2, Greeley, CO 970-515-5294

# WELL LOCATION CERTIFICATE


WELLS RANCH STATE A36-655

SECTION: 31  
TOWNSHIP: 6N  
RANGE: 63W  
6TH. P.M.  
WELD COUNTY, CO

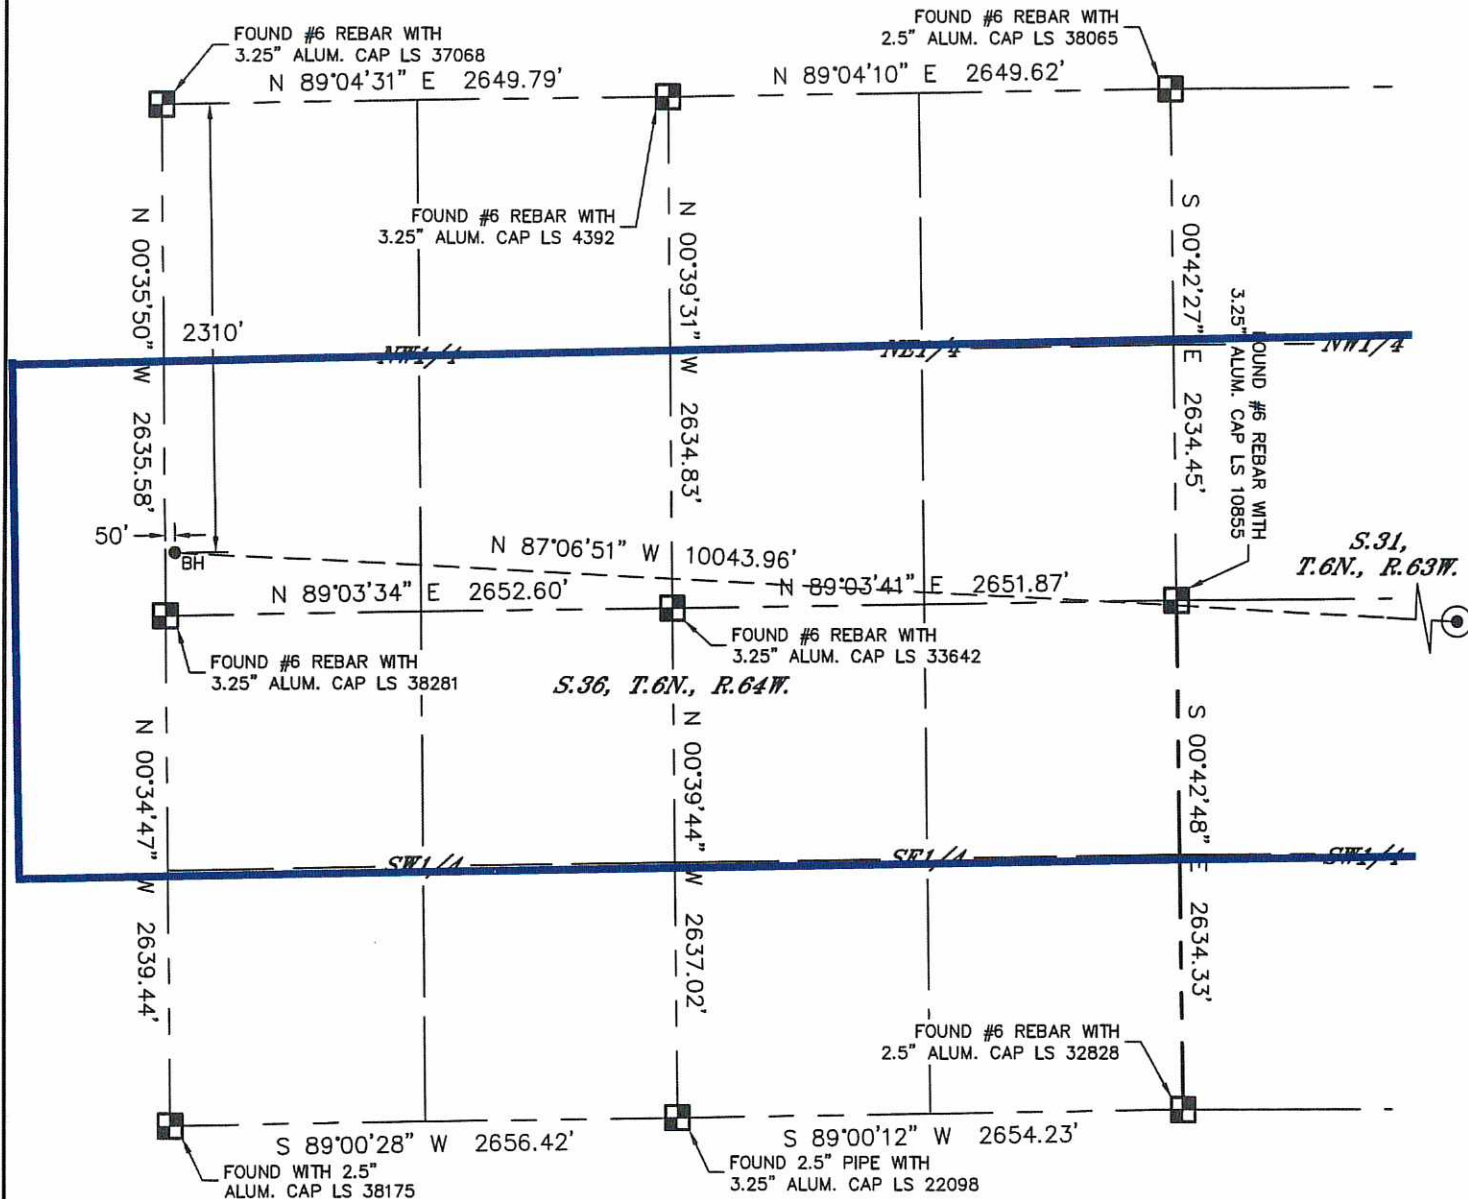

## LEGEND

- = ALIQUOT MONUMENT AS DESCRIBED
- = CALCULATED POSITION
- ⊙ = SURFACE HOLE LOCATION (SHL)
- ▲ = ENTRY POINT LOCATION (EP)
- = BOTTOM HOLE LOCATION (BHL)
- ⊕ = EXISTING WELL
- ⊖ = ABANDONED WELL

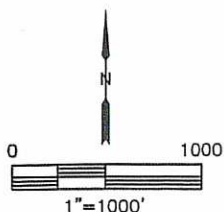

SHEET 2 OF 2

Kyle E. Rutz—On behalf of Lat40, Inc.  
Colorado Licensed Professional Land Surveyor No. 38307  
DATE: 12/2/2014  
PROJECT#: 2014164