

**KERR-MCGEE OIL AND GAS ONSHORE LP**

**BERRY 8-8**

**SE NE 8 3N 67W 2,174' FNL 465' FEL**

**WELD,COLORADO**

**03/26/2015**

**AREA: NH**

**ROUTE: NH5 Spud: 11/18/2003**

**WINS No.: 76837**

**AFE/WO#: 2107662**

**API#: 0512321688**

**GL: 4800**

**KB: 4812**

**MTD: 7267**


**TVD: 7267**

**LOG MD: 7265**

**PBMD: 7235**

**PBTVD: 7235**

**Directions: WCR 34 & WCR 17, N 1/2, W INTO**

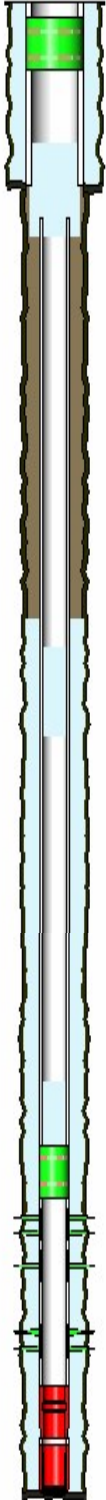

<u>HOLE SECTIONS</u>		<u>Size</u>	<u>Top</u>	<u>Btm</u>	<u>TD Date</u>			
SURFACE		12.25	12	809	11/18/2003			
PRODUCTION		7.88	809	7267	11/22/2003			
<u>TUBULARS</u>	<u>Tool Type</u>	<u>Joints</u>	<u>Size</u>	<u>Weight</u>	<u>Grade</u>	<u>Thread</u>	<u>Top D</u>	<u>Bottom D</u>
SURFACE CASING	Casing	18	8.63	24	J-55	STC	12	799
BRIDGE PLUG	Cast Iron Bridge Plu	1	4.50				6790	6791
PRODUCTION CASING	Casing	147	4.50	11.6	I-80	LTC	1000	7235
	Casing Float Collar	1	4.50				7235	7236
	Casing	1	4.50	11.6	I-80	LTC	7236	7261
	Casing Guide Shoe	1	4.50				7261	7262
BRIDGE PLUG	Cast Iron Bridge Plu	1	8.68				80	82
<u>CEMENT JOBS</u>	<u>Stage</u>	<u>Sacks</u>	<u>Cement Jobs</u>			<u>Top D</u>	<u>Btm D</u>	<u>cbl</u>
SURFACE CASING	PRIM CMT 1ST STAGE		LEAD			12	809	No
PRODUCTION CASING	STAGE 1 LEAD	190		LITE		3502	4530	Yes
	STAGE 1 MIDDLE	85		LITE		4530	6160	Yes
	STAGE 1 TAIL	190		50/50 POZ-MIX		6160	7262	Yes
PRODUCTION CASING	ABANDONMENT PLUC	25	LEAD-1	CEMENT		6390	6783	No
	ABANDONMENT PLUC	40	LEAD-2	CEMENT		3680	4239	No
PRODUCTION CASING	ABANDONMENT PLUC	150	LEAD	CEMENT		533	1112	No
<u>PERFORATIONS</u>								
<u>Formation</u>	<u>Zone</u>	<u>Top</u>	<u>Btm</u>	<u>Date</u>	<u>Reason</u>	<u>Comments</u>		
NIOBRARA		6846	6849	12/04/2003	PRODUCTION			
NIOBRARA		6898	6902	12/04/2003	PRODUCTION			
CODELL		7102	7114	12/02/2003	PRODUCTION			
CODELL		7102	7114	03/13/2007	PRODUCTION			

Comments: