


Well Name: BEST 01 API 05735

VERTICAL - ORIGINAL HOLE, 2/24/2015 2:23:19 PM

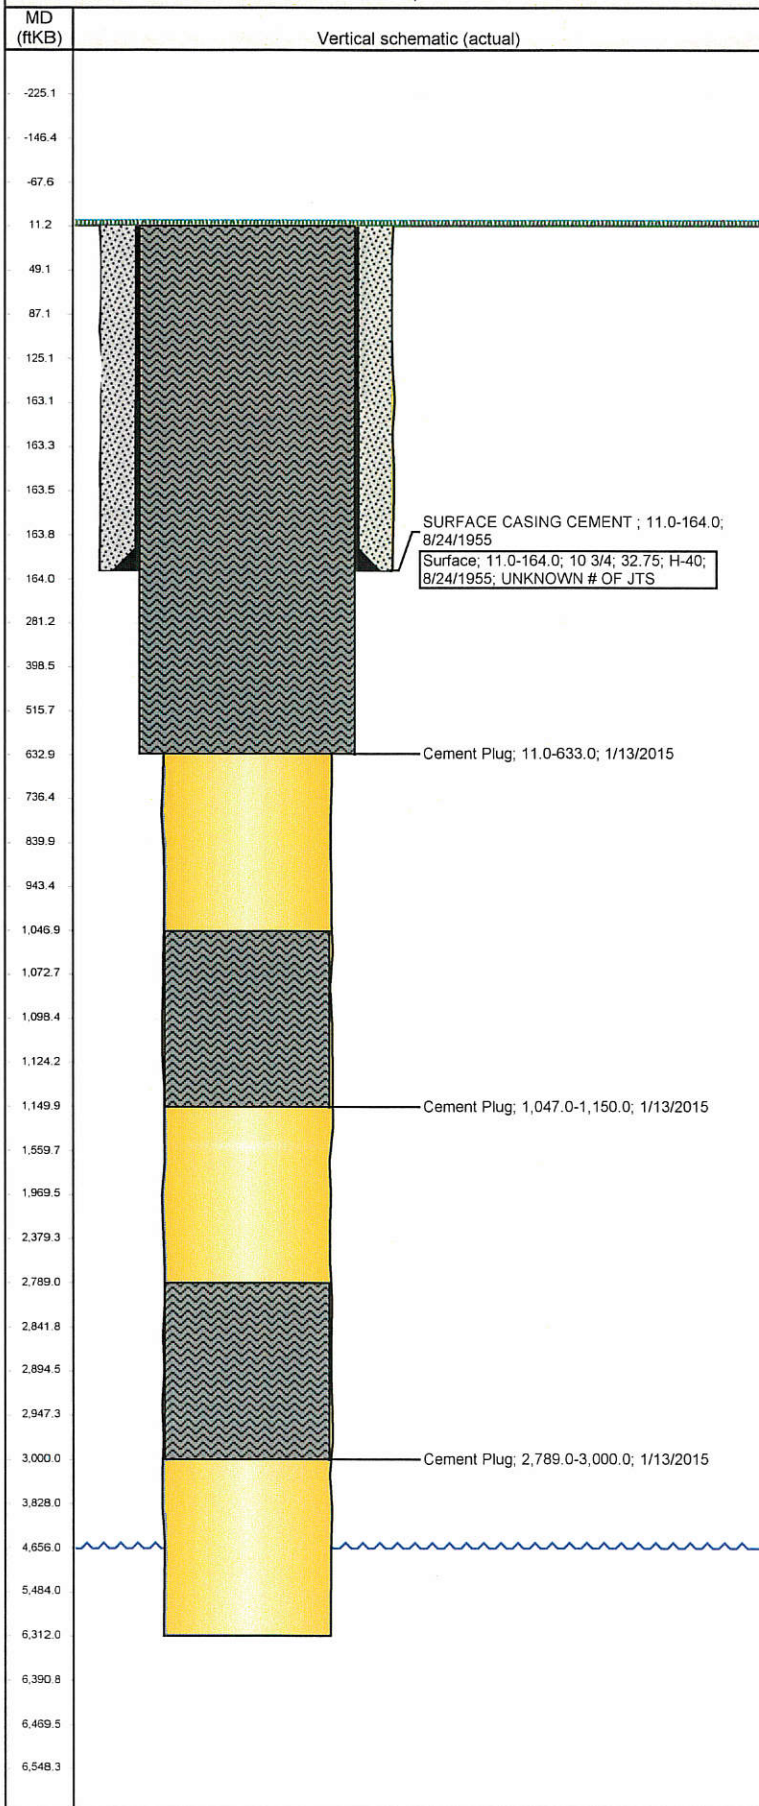

## Well Header

API	Business Unit	District	Well Config
05-123-05735	DJ BASIN	15	VERTICAL
Original KB Elevation (ft)	KB - GL / MSL (ftKB)	Spud Date	P & A Date
4,674.00	11.00	8/24/1955	1/13/2015

Comment  
WBI - RE-ENTRY - MINIMAL DATA - NO ORIGINAL PLUGGING DETAILS ON COGCC

Directions To Well

Current PBTD (ftKB)

## Bottom Hole Location

North-South Distance (ft)	From N or S Line	East-West Distance (ft)	From E or W Line
---------------------------	------------------	-------------------------	------------------

## Plug Back Total Depths

Date	Depth (ftKB)	Method	Com

## Wellbore Sections

Section Des	Size (in)	Act Top, MD (ftKB)	Act Btm, MD (ftKB)
SURFACE	13 3/4	11.0	164.0
OPENHOLE	7 7/8	164.0	6,312.0

## Zone Statuses

Zone Name	Status Date	Status	Fluid Type	Job

## Casing Strings

Csg Des	Run Date	OD (in)	Wt/Len (lb/ft)	Grade	Top, MD (ftKB)	MD (ftKB)
Surface	8/24/1955	10 3/4	32.75	H-40	11.0	164.0

## Cement

Des	Top (ftKB)	Btm (ftKB)
SURFACE CASING CEMENT	11.0	164.0
Cement Plug	1,047.0	1,150.0
Cement Plug	2,789.0	3,000.0
Cement Plug	11.0	633.0

## Tubing Components

Item Des	OD (in)	Wt (lb/ft)	Grade	Jts	Len (ft)

## Perforation Data

Zone	Bnch/St g	Entered Shot Total	Top (ftKB)	Btm (ftKB)	Date

## Other In Hole

Run Date	Des	OD (in)	Top (ftKB)	Btm (ftKB)

## Logs

Date	Type	Top, MD (ftKB)	Btm, MD (ftKB)