

Well

Operator
Location
County
State
Field
Footages:
Spud Date: 12-28-2008
TD Date: 01-03-2008

DUCKWORTH 6-0-16

EnCana Oil & Gas (USA) Inc.
SENE Sec. 16-T2N-R68W
Weld
Colorado
Wattenberg
1685' FNL & 1034' FEL


RECEIVED

APR 02 2009

COGCC

Log Tops

Sussex	4460'
Shannon	4906'
Niobrara	7416'
Codell	7650'
J Sand	8068'

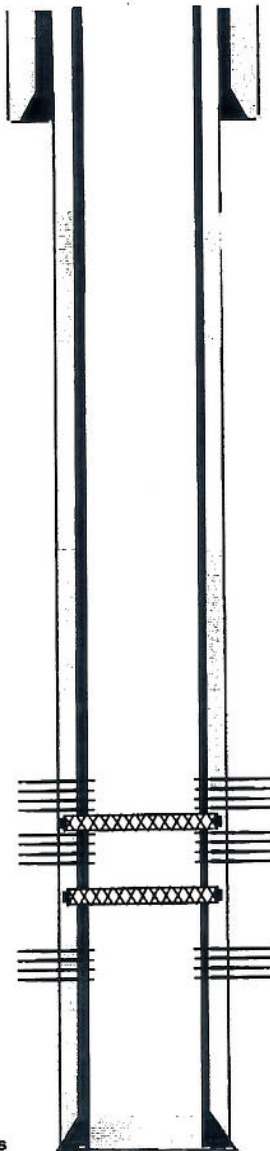

8220' — Driller's
TD

Surface Casing and Cement

8 5/8", 24#, landed @ 729', cemented with 340 sxs

Main Hole

7-7/8" to TD

Production Casing and Cement

4-1/2", 11.6#, landed @ 8207', cemented with 230 sxs

DV Tool

Set @ 5270', cemented above DV tool with 300 sxs

Perf'd the Niobrara from 7482' - 7496' @ 2 spf

Frac'd the Niobrara with 127,680 gal 18# Vistar Hybrid cross linked gel with 250,140# sand. 01-28-09

CFP

Set @ 7590' on 01-13-09

Perf'd the Codell 7650' - 7670' @ 4 spf

Frac'd the Codell with 108,486 gal 24# Vistar Hybrid cross linked gel containing 250,780# sand. 01-13-09

CFP

Set @ 7770'. 01-13-09

Perf'd the J Sand from 8082' - 8100' @ 2 spf

Frac'd the J Sand with 155,064 gal 20# Vistar Hybrid cross linked gel containing 250,600# sand. 01-13-09